

Stone
 H 2010
 3-15-79
 3-15

MISSISSIPPI
 BOARD OF WATER COMMISSIONERS
 416 North State Street
 Jackson, Mississippi 39201

WATER WELL DRILLERS LOG

date well completed

firm name

county well located

1979 *Donnell*

LANDOWNER:	description of formations encountered	from	to
<i>Mike McCardle</i>			
(mailing address)	<i>Clay</i>	<i>2</i>	<i>68</i>
WELL LOCATION:	<i>Fin Sand</i>	<i>68</i>	<i>85</i>
sec. <i>2</i> T. <i>2</i> N. <i>3</i> R. <i>LE</i>			
<i>7</i> miles <i>W</i> of <i>Bond</i>			
(distance) (direction) (nearest town)			
WELL PURPOSE: <i>HOME</i>			
(home, irrigation, municipal, industrial)			
WELL COMPLETION DATA:			
(1) diameter (inches) <i>2"</i>			
(2) total depth (feet) <i>82'</i>			
(3) static water level (feet) <i>70</i> below top of ground.			
(4) casing <i>Plastic 73'</i>			
(material) (depth)			
(size) if telescope see back.			
(5) screen <i>5'</i> <i>73'</i>			
(length) (depth to top)			
<i>2"</i> <i>Plastic</i>			
(size) (material)			
(6) pump <i>1</i> <i>7</i>			
(HP) (yield gpm)			
<i>Elect</i>			
(type power)			
(7) electric log <i>no</i>			
(yes or no)			
(organization running log)			
(8) how well bottom plugged <i>Capped</i>			

Miss. Board of Water Comm.


APR 2 - 1979

DRILLERS REMARKS:

RECEIVED

If well telescopes please sketch and show depths.

GROUND LEVEL

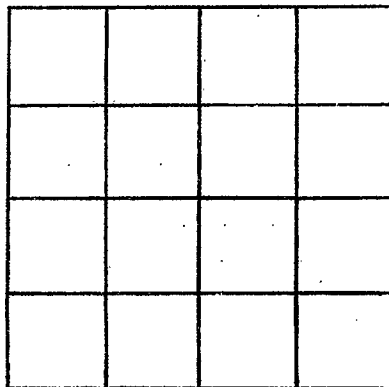

SECTION _____

Please indicate well location X.

ADDITIONAL INFORMATION

If more than one screen,
show locations of each on sketch.