

Stone
A 2011
8-15-79

MISSISSIPPI
BOARD OF WATER COMMISSIONERS
416 North State Street
Jackson, Mississippi 39201

WATER WELL DRILLERS LOG

8-15 1979 Pearl Anderson Stone
date well completed firm name county well located

LANDOWNER:	description of formations encountered	from	to
Eddie Taylor	Top Soil	0	2
(mailing address)	Firm Sand	2	54
WELL LOCATION:			
sec. <u>25</u> T <u>2</u> N R <u>13</u> E S W <u>7</u> miles <u>W</u> of <u>Wadsworth</u> (distance) (direction) (nearest town)			
WELL PURPOSE: <u>HOME</u> (home, irrigation, municipal, industrial)			
WELL COMPLETION DATA:			
(1) diameter (inches) <u>2"</u>			
(2) total depth (feet) <u>54'</u>			
(3) static water level (feet) <u>42'</u> below top of ground.			
(4) casing <u>Plastic</u> , <u>49'</u> (material) (depth)			
_____ if telescope see back. (size)			
(5) screen <u>5"</u> , <u>49'</u> (length) (depth to top)			
<u>2"</u> , <u>Plastic</u> (size) (material)			
(6) pump <u>1</u> , <u>6</u> (HP) (yield gpm)			
<u>Elect</u> (type power)			
(7) electric log <u>na</u> (yes or no)			
_____ (organization running log)			
(8) how well bottom plugged _____			
<u>Chipped</u>			
DRILLERS REMARKS:			


Miss. Board of Water Comm.

SEP 11 1979

RECEIVED

If well telescopes please sketch and show depths.

GROUND LEVEL

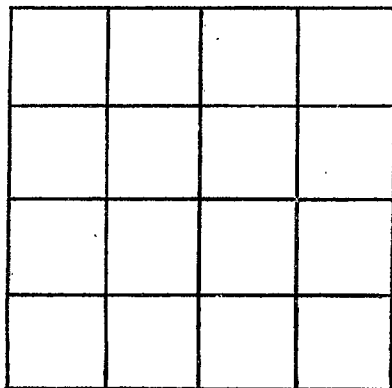

SECTION _____

Please indicate well location X.

ADDITIONAL INFORMATION

If more than one screen,
show locations of each on sketch.