

Stone

MISSISSIPPI
BOARD OF WATER COMMISSIONERS
416 North State Street
Jackson, Mississippi 39201

WATER WELL DRILLERS LOG

A 2013
6-11-80
6-11

date well completed

1980 *Parnell Anderson Stone*

firm name

county well located

LANDOWNER:
Dilly Eastland

(mailing address)

description of formations encountered	from	to
<i>Top Soil</i>	<i>0</i>	<i>3</i>
<i>Course Sand</i>	<i>3</i>	<i>52</i>

WELL LOCATION:

sec. *19* T. *2* S. R. *13* W.

1 1/2 miles *W* of *W. Logan*

(distance) (direction) (nearest town)

WELL PURPOSE: *HOME*

(home, irrigation, municipal, industrial)

WELL COMPLETION DATA:

(1) diameter (inches) *2"*

(2) total depth (feet) *5-2'*

(3) static water level (feet) *11'* below above top of ground.

(4) casing *Plastic*, *47'*

(material) (depth)

_____ If telescope see back.
(size)

(5) screen *5"*, *47'*

(length) (depth to top)

2", *Plastic*

(size) (material)

(6) pump *1*, *11*

(HP) (yield gpm)

Elect

(type power)

(7) electric log *No*

(yes or no)

_____ (organization running log)

(8) how well bottom plugged *Capped*

DRILLERS REMARKS:


DEPT. OF NATURAL RESOURCES
BUREAU OF LAND & WATER RESOURCES

JUN 16 1980

RECEIVED

If well telescopes please sketch and show depths.

GROUND LEVEL

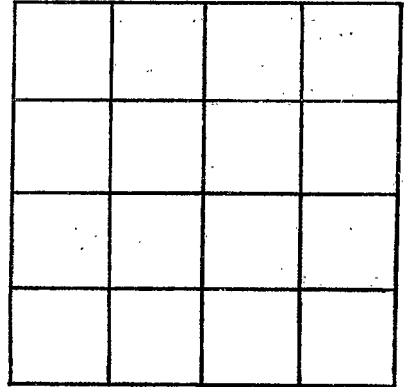

SECTION _____

Please indicate well location X.

ADDITIONAL INFORMATION

If more than one screen,
show locations of each on sketch.