

MISSISSIPPI DEPARTMENT OF NATURAL RESOURCES

Bureau of Land and Water Resources

Southport Mall

P.O. Box 10631

Jackson, Mississippi 39209

WATER WELL DRILLERS LOG

Stone
A 2014

4/3/81
April 3 1981
date well completed

81 Parnell Anderson Stone
firm name

county well located


LANDOWNER:	description of formations encountered	from	to
P.O. Box 1487 Lacombe La 70445 (mailing address)			
WELL LOCATION:			
sec 29 T 2 N R 13 E 18 miles W of Wiggins (distance) (direction) (nearest town)			
WELL PURPOSE: Home (home, irrigation, municipal, industrial)			
WELL COMPLETION DATA:			
(1) diameter (inches) 2"			
(2) total depth (feet) 51'			
(3) static water level (feet) 35' below top of ground.			
(4) casing PVC, 46' (material) (depth)			
(size) if telescope see back.			
(5) screen 5' 46' (length) (depth to top)			
2" PVC (size) (material)			
(6) pump (HP) (yield gpm)			
Electric (type power)			
(7) electric log (yes or no)			
(organization running log)			
(8) how well bottom plugged yes			
DRILLERS REMARKS:			

DEPT. OF NATURAL RESOURCES
BUREAU OF LAND & WATER RESOURCES

RECEIVED
MAY 18 1981

If well telescopes please sketch and show depths.

GROUND LEVEL

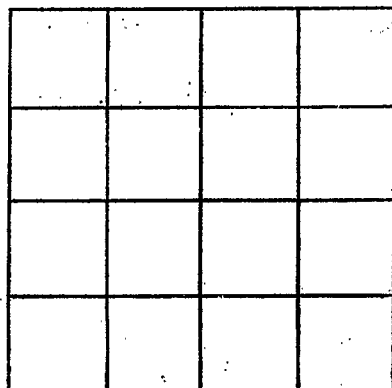

SECTION _____

Please indicate well location X.

ADDITIONAL INFORMATION

If more than one screen,
show locations of each on sketch.