

MISSISSIPPI DEPARTMENT OF NATURAL RESOURCES

Bureau of Land and Water Resources

Southport Mall

P.O. Box 10631

Jackson, Mississippi 39209

WATER WELL DRILLERS LOG

Stone
A 2015
8-19-81

8-19

1981

Parnell Andersen Stone

date well completed

firm name

county well located

LANDOWNER:

J. J. Lodner

description of formations encountered

from

to

Rt 3 Box 60

Top soil

0 3

Sumbertown, Ms
(mailing address)

Sand
Sand

3 28
28 64

WELL LOCATION:

sec. 2 T. 2 N. R. 13 E. S. 5 W.
7.6 miles W of Wiggins
(distance) (direction) (nearest town)

WELL PURPOSE:

Home
(home, irrigation, municipal, industrial)

WELL COMPLETION DATA:

- (1) diameter (inches) 2"
- (2) total depth (feet) 64'
- (3) static water level (feet) 48' below top of ground.
- (4) casing PVC 59'
(material) (depth)

if telescope see back.
(size)

- (5) screen 5' 59'
(length) (depth to top)

2' PVC
(size) (material)

- (6) pump 1 HP 11
(HP) (yield gpm)

Electric
(type power)

- (7) electric log No
(yes or no)

(organization running log)

- (8) how well bottom plugged Capped

DRILLERS REMARKS:

DEPT. OF NATURAL RESOURCES
BUREAU OF LAND & WATER RESOURCES

OCT - 2 1981


RECEIVED

~~44:8V | 11318~~
~~81 SEP 1 48:44~~

RECEIVED

If well telescopes please
sketch and show depths.

GROUND LEVEL

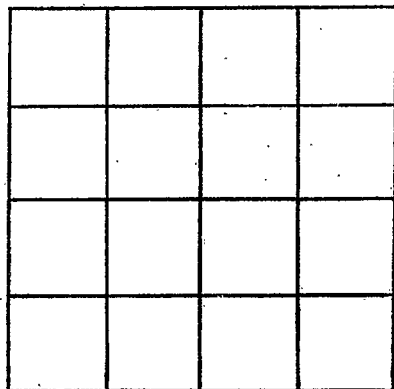

SECTION _____

Please indicate well location X.

ADDITIONAL INFORMATION

If more than one screen,
show locations of each on sketch.