

MISSISSIPPI DEPARTMENT OF NATURAL RESOURCES

Bureau of Land and Water Resources

Southport Mall

P.O. Box 10631

Jackson, Mississippi 39209

WATER WELL DRILLERS LOG

STONE
A 209E
10-9-81

10-9 1981 Frank Price Stone  
 date well completed firm name county well located

LANDOWNER:	description of formations encountered	from	to
<u>Mrs Marge Rabby</u>	<u>Top Soil</u>	<u>0</u>	<u>2</u>
(mailing address)	<u>Clay</u>	<u>2</u>	<u>215</u>
WELL LOCATION:	<u>Fine Sand</u>	<u>215</u>	<u>222</u>
sec <u>20</u> T <u>2</u> R <u>13</u>	<u>Clay</u>	<u>222</u>	<u>245</u>
<u>Lake Joe - clear</u>	<u>Course Sand</u>	<u>245</u>	<u>258</u>
(distance) miles (direction) of (nearest town)			
WELL PURPOSE: <u>HOME</u>			
(home, irrigation, municipal, industrial)			
WELL COMPLETION DATA:			
(1) diameter (inches) <u>2"</u>			
(2) total depth (feet) <u>258'</u>			
(3) static water level (feet) <u>112'</u> below above top of ground.			
(4) casing <u>Plastic, 253'</u> (material) (depth)			
(size) if telescope see back.			
(5) screen <u>5'</u> <u>253'</u> (length) (depth to top)			
<u>2"</u> <u>Plastic</u> (size) (material)			
(6) pump <u>1/2</u> <u>5'</u> (HP) (yield gpm)			
<u>Elect</u> (type power)			
(7) electric log <u>no</u> (yes or no)			
(organization running log)			
(8) how well bottom plugged <u>Back with valve</u>			

DEPT. OF NATURAL RESOURCES  
 BUREAU OF LAND & WATER RESOURCES


NOV 3 - 1981

RECEIVED

DRILLERS REMARKS:

If well telescopes please sketch and show depths.

GROUND LEVEL

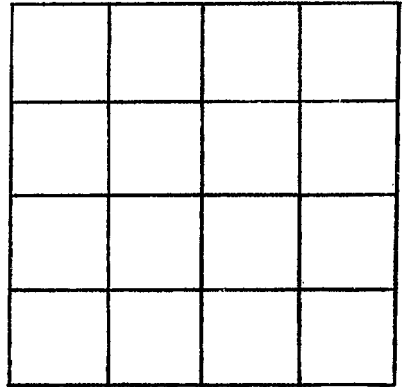

SECTION \_\_\_\_\_

Please indicate well location X.

ADDITIONAL INFORMATION

If more than one screen,  
show locations of each on sketch.