

MISSISSIPPI DEPARTMENT OF NATURAL RESOURCES

Bureau of Land and Water Resources

Southport Mall

P.O. Box 10631

Jackson, Mississippi 39209

WATER WELL DRILLERS LOG

Stone
A 2017
11-18-81

11-18 1981 Frank Price Stone
date well completed firm name county well located

LANDOWNER:	description of formations encountered	from	to
<u>Hazel Thompson</u>	<u>Top Soil</u>	<u>0</u>	<u>3</u>
(mailing address)	<u>Clay</u>	<u>3</u>	<u>118</u>
WELL LOCATION:	<u>fine sand</u>	<u>118</u>	<u>148</u>
sec. <u>11</u> T. <u>2</u> R. <u>13</u>	<u>Course Sand</u>	<u>148</u>	<u>160</u>
<u>3</u> miles <u>NE</u> of <u>Salter Co. Tenn</u>			
(distance) (direction) (nearest town)			
WELL PURPOSE: <u>HOME</u>			
(home, irrigation, municipal, industrial)			
WELL COMPLETION DATA:			
(1) diameter (inches) <u>2"</u>			
(2) total depth (feet) <u>160'</u>			
(3) static water level (feet) <u>63</u> below top of ground.			
(4) casing <u>Plastic, 155'</u>			
(material) (depth)			
if telescope see back.			
(size)			
(5) screen <u>5'</u> , <u>155'</u>			
(length) (depth to top)			
<u>2"</u> , <u>Plastic</u>			
(size) (material)			
(6) pump <u>1</u> <u>8</u>			
(HP) (yield gpm)			
<u>Elast</u>			
(type power)			
(7) electric log <u>no</u>			
(yes or no)			
(organization running log)			
(8) how well bottom plugged <u>Capped</u>			
DRILLERS REMARKS:			


DEPT. OF NATURAL RESOURCES
BUREAU OF LAND & WATER RESOURCES

DEC - 9 1981

RECEIVED

If well telescopes please sketch and show depths.

GROUND LEVEL

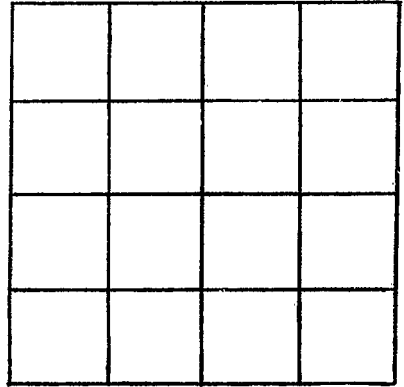

SECTION _____

Please indicate well location X.

ADDITIONAL INFORMATION

If more than one screen, show locations of each on sketch.