

Stone  
 A 2018  
 12/11/81

MISSISSIPPI  
 BOARD OF WATER COMMISSIONERS  
 416 North State Street  
 Jackson, Mississippi 39201

WATER WELL DRILLERS LOG

Dec 1 1981 Raymond Anderson Stone  
 date well completed firm name county well located

LANDOWNER: Raymond Anderson Stone

description of formations encountered

from to

<u>P.O. Box 415</u>	<u>Top Soil</u>	<u>0</u>	<u>3</u>
<u>Wiggins Ms 39547</u>	<u>clay</u>	<u>3</u>	<u>17</u>
(mailing address)	<u>sand</u>	<u>17</u>	<u>28</u>
	<u>clay</u>	<u>28</u>	<u>40</u>
	<u>sand</u>	<u>40</u>	<u>55</u>

WELL LOCATION:

sec. 19 T. 2 R. 13  
 S

10 miles W of Wiggins  
 (distance) (direction) (nearest town)

WELL PURPOSE: Home  
 (home, irrigation, municipal, industrial)

WELL COMPLETION DATA:

- (1) diameter (inches) 2"  
 (2) total depth (feet) 55'  
 (3) static water level (feet) 48' below top of ground.  
 (4) casing PVC 50'  
 (material) (depth)

if telescope see back.  
 (size)

- (5) screen 5' 50'  
 (length) (depth to top)  
2" PVC  
 (size) (material)

- (6) pump 1 10  
 (HP) (yield gpm)  
Electric  
 (type power)

- (7) electric log No  
 (yes or no)

(organization running log)

- (8) how well bottom plugged Capped

DRILLERS REMARKS:


DEPT. OF NATURAL RESOURCES  
 BUREAU OF LAND & WATER RESOURCES

DEC 30 1981

RECEIVED

If well telescopes please sketch and show depths.

GROUND LEVEL

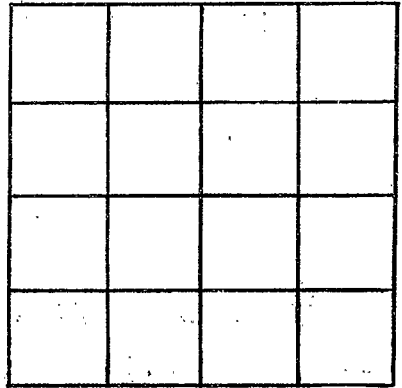

SECTION \_\_\_\_\_

Please indicate well location X.

ADDITIONAL INFORMATION

If more than one screen, show locations of each on sketch.