

MISSISSIPPI DEPARTMENT OF NATURAL RESOURCES

Bureau of Land and Water Resources

Southport Mall

P.O. Box 10631

Jackson, Mississippi 39209

WATER WELL DRILLERS LOG

Stone
A 205

2-19 1982 date well completed Frank Price firm name Stone county well located

LANDOWNER:	description of formations encountered	from	to
Jim McGuire	Top Soil	0	2
(mailing address)	Red Clay	2	22
WELL LOCATION:	Coarse Sand	22	70
sec. 30 T. 2 R. 13	Seen		
2 miles SW of Lakebrook			
WELL PURPOSE: HOME			
(home, irrigation, municipal, industrial)			
WELL COMPLETION DATA:			
(1) diameter (inches) 4"			
(2) total depth (feet) 70'			
(3) static water level (feet) 35' below top of ground.			
(4) casing Plastic, 60' (material) (depth)			
(size) if telescope see back.			
(5) screen 10' length, 60' depth to top			
4" (size) Plastic (material)			
(6) pump 1/2 HP, 15 (yield gpm)			
Elect (type power)			
(7) electric log NO (yes or no)			
(organization running log)			
(8) how well bottom plugged Backwash valve			
DRILLERS REMARKS:			


DEPT. OF NATURAL RESOURCES
BUREAU OF LAND & WATER RESOURCES

MAR 23 1982

RECEIVED

If well telescopes please sketch and show depths.

GROUND LEVEL

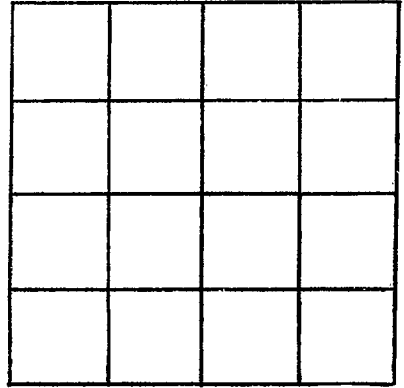

SECTION _____

Please indicate well location X.

ADDITIONAL INFORMATION

If more than one screen,
show locations of each on sketch.