

Stone  
A 2020

MISSISSIPPI  
BOARD OF WATER COMMISSIONERS  
416 North State Street  
Jackson, Mississippi 39201

WATER WELL DRILLERS LOG

April 22 1983 Farmer Anderson Stone  
date well completed firm name county well located

LANDOWNER: Albert Jackson

description of formations encountered

from to

Rt  
Wiggins, Ms  
(mailing address)

Top soil	0	2
Clay	2	25
Sand	22	41
Blue Clay	41	100
Sand	100	122

WELL LOCATION:

sec. 1 T 2 S R 13 W  
15 miles W of Wiggins  
(distance) (direction) (nearest town)

WELL PURPOSE: Home  
(home, irrigation, municipal, industrial)

WELL COMPLETION DATA:

- (1) diameter (inches) 2"
- (2) total depth (feet) 122'
- (3) static water level (feet) 80' below top of ground.
- (4) casing PVC  
(material) (depth)
- (size) If telescope see back.
- (5) screen 5 117'  
(length) (depth to top)
- 2" PVC  
(size) (material)
- (6) pump 1 9  
(HP) (yield gpm)
- Electric  
(type power)
- (7) electric log NO  
(yes or no)

(organization running log)

(8) how well bottom plugged Capped

DRILLERS REMARKS:


DEPT. OF NATURAL RESOURCES  
BUREAU OF LAND & WATER RESOURCES

JUN - 2 1983

RECEIVED

If well telescopes please sketch and show depths.

GROUND LEVEL

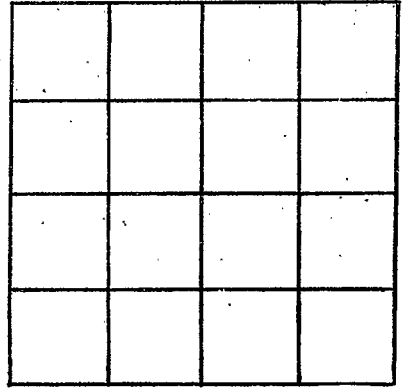

SECTION \_\_\_\_\_

Please indicate well location X.

ADDITIONAL INFORMATION

If more than one screen, show locations of each on sketch.