

MISSISSIPPI DEPARTMENT OF NATURAL RESOURCES

Bureau of Land and Water Resources

Southport Mall

P.O. Box 10631

Jackson, Mississippi 39209

WATER WELL DRILLERS LOG

STONE
A
2024

6-6-1986 date well completed Parwell Anderson Stone firm name Stone county well located

LANDOWNER: <u>Dan Roberts</u>	description of formations encountered	from	to
<u>Lumberton Miss</u>			
	<u>Clay</u>	<u>2</u>	<u>12</u>
(mailing address)	<u>Sand</u>	<u>12</u>	<u>77</u>
WELL LOCATION:			
sec. <u>10</u> T. <u>2</u> S. R. <u>13</u> W.			
<u>18</u> miles <u>West</u> of <u>Wiggins</u>			
(distance) (direction) (nearest town)			
WELL PURPOSE: <u>Home</u>			
(home, irrigation, municipal, industrial)			
WELL COMPLETION DATA:			
(1) diameter (inches) <u>77</u>			
(2) total depth (feet) <u>77</u>			
(3) static water level (feet) <u>25</u> below above top of ground.			
(4) casing <u>PVC</u> , <u>72</u> , (material) (depth)			
(size) if telescope see back.			
(5) screen <u>5</u> , <u>72</u> (length) (depth to top)			
<u>2</u> , <u>PVC</u> (size) (material)			
(6) pump <u>1</u> , <u>12</u> (HP) (yield gpm)			
<u>Electric</u> (type power)			
(7) electric log <u>NO</u> (yes or no)			
(organization running log)			
(8) how well bottom plugged <u>Cap</u>			

RECEIVED


JUN 12 1986

Department of Natural Resources
Bureau of Land & Water

DRILLERS REMARKS:

If well telescopes please sketch and show depths.

GROUND LEVEL

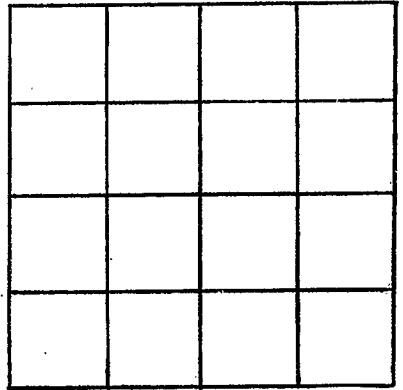

SECTION _____

Please indicate well location X.

ADDITIONAL INFORMATION

If more than one screen,
show locations of each on sketch.