

MISSISSIPPI DEPARTMENT OF ENVIRONMENTAL QUALITY

Office of Land and Water Resources

P. O. Box 10631
Jackson, MS 39289-0631
WATER WELL DRILLERS LOG

COUNTY WELL LOCATED
Stone

WELL NUMBER
A-20481

DATE WELL COMPLETED
11/3/99

PERMIT NUMBER

NAME OF DRILLING FIRM
Boone's Water Well

NAME & MAILING ADDRESS OF LANDOWNER
Jack Kelly

145 Virgil Smith Rd

Lumberton MS 39453

WELL LOCATION: SEC 32 TOWNSHIP 2 RANGE 13 E

DISTANCE 10 MILES E DIRECTION E NEAREST TOWN Poplarville

OTHER LANDMARK

WELL PURPOSE: Home Irrigation, Municipal, Industrial, Fish Pond, etc.

PUMP DATA

PUMP TYPE (Circle One):
 Submersible Turbine, Jet Flowing Well,
Other (Describe)

POWER TYPE (Circle One):
 Electric Tractor, Diesel, Gasoline, Butane,
Other (Describe) H/P

Pump Capacity (GPM) 20 No. of Stages Setting Depth 1 FT.

PUMP TEST

Well yielded _____ GPM with
a drawdown of _____ ft.
after _____ hours of pumping

WELL DATA

Well Depth <u>140</u>	Casing Diameter (In.) <u>4</u>	Casing Length (Ft.) <u>120</u>
Type of Casing <u>Sch 40</u>	Hole Depth <u>140</u>	Depth to Static Water Level <u>70</u>

LOG DATA

TYPE OF LOG RUN (Circle One):
 No Log Run, Electric, Gamma Ray, Density, Sonic, Neutron,
Other (Describe)

Name of Organization Running Log

TYPE OF COMPLETION: (Circle One or More):
 Gravel Packed, Underreamed, Telescoped,
 Natural Development, Open Hole, Other

WELL GROUTED TO A DEPTH OF 10 FEET
Type Grout (circle one): Cement, Bentonite, or Mix

GEOLOGIC DATA (Office Use Only)

Surface Elev.	Geologic Unit	Unit Thickness	Depth to Top
Subs. SWL	Date	Analysis	Aquifer Test

SCREEN DATA

Diameter - Inches <u>4</u>	Length - Feet <u>20</u>	Slot Size - Inches <u>#8</u>
Screen Type <u>Sch 40</u>	Depth to Bottom - Feet	

Driller's Remarks

Top of Lap Pipe or Reduction in Casing

FEET IF TELESCOPED OR MORE THAN ONE SCREEN USE BACK PAGE


DESCRIPTION OF FORMATIONS ENCOUNTERED	FROM	TO	DESCRIPTION OF FORMATIONS ENCOUNTERED	FROM	TO
<u>Sand</u>	<u>0</u>	<u>140</u>			

10-15-2000
JUL 27 2000
Dept. of Environmental Quality
Office of Land & Water Resources

IF MORE SPACE IS NEEDED, USE BACK

If well telescopes please
sketch and show depths.

GROUND LEVEL

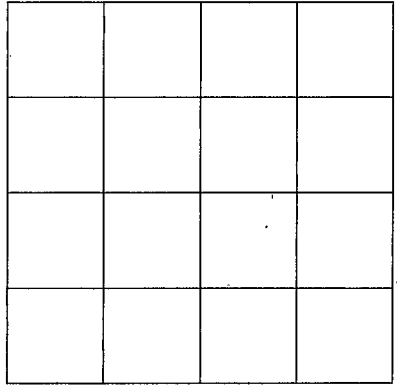

SECTION _____

Please indicate well location X.

ADDITIONAL INFORMATION

If more than one screen,
show location of each on sketch.
