

MISSISSIPPI DEPARTMENT OF ENVIRONMENTAL QUALITY

Office of Land and Water Resources

COUNTY WELL LOCATED Stone	
WELL NUMBER A-2053	CODED:
DATE WELL COMPLETED 5/23/01	

PERMIT NUMBER
NAME OF DRILLING FIRM Moores Water Well Service
31R. Moore Rd, Wiggins

P. O. Box 10631
Jackson, MS 39289-0631
WATER WELL DRILLERS LOG

NAME & MAILING ADDRESS OF LANDOWNER Tony Collier			
3 A. L. Rd.			
humberton, MS.			
WELL LOCATION:	SEC	TOWNSHIP	RANGE
	5	2	S 13 W
DISTANCE	DIRECTION	NEAREST TOWN	
OTHER LANDMARK Stump Texas			
WELL PURPOSE <input type="checkbox"/> Home <input type="checkbox"/> Irrigation, Municipal, Industrial, Fish Pond, etc.			

PUMP DATA		
PUMP TYPE (Circle One): Submersible, Turbine, <input checked="" type="radio"/> Jet, Flowing Well, Other (Describe) _____		
POWER TYPE (Circle One): <input checked="" type="radio"/> Electric, Tractor, Diesel, Gasoline, Butane, Other (Describe) _____ H/P _____		
Pump Capacity (GPM) 10	No. of Stages 2	Setting Depth _____ FT.
PUMP TEST		
Well yielded _____ GPM with a drawdown of _____ ft. after _____ hours of pumping		

WELL DATA		
Well Depth 91'	Casing Diameter (In.) 2"	Casing Length (Ft.) 81'
Type of Casing PVC	Hole Depth 91'	Depth to Static Water Level 22'

LOG DATA	
TYPE OF LOG RUN (Circle One): No Log Run, Electric, Gamma Ray, Density, Sonic, Neutron, Other (Describe) _____	
Name of Organization Running Log	

TYPE OF COMPLETION: (Circle One or More):
 Gravel Packed, Underreamed, Telescoped,
 Natural Development, Open Hole, Other
 (Describe) _____

WELL GROUTED TO A DEPTH OF **10** FEET.
 Type Grout (circle one): Cement, Bentonite, or Mix

GEOLOGIC DATA (Office Use Only)			
Surface Elev.	Geologic Unit	Unit Thickness	Depth to Top
Subs. SWL	Date	Analysis	Aquifer Test
Driller's Remarks			
Top of Lap Pipe or Reduction in Casing			
FEET	IF TELESCOPED OR MORE THAN ONE SCREEN: USE BACK PAGE		

SCREEN DATA		
Diameter - Inches 2"	Length - Feet 10'	Slot Size - Inches .08
Screen Type PVC sch 40	Depth to Bottom - Feet 91'	


DESCRIPTION OF FORMATIONS ENCOUNTERED	FROM	TO	FORMATIONS (Continued)	
			FROM	TO
topsoil	1'	2'		
red sandy clay	2'	10'		
white soapstone	10'	24'		
coarse white sand	24'	91'		

REC'D JUL 02 2001

IF MORE SPACE IS NEEDED, USE BACK

If well telescopes please
sketch and show depths.

GROUND LEVEL

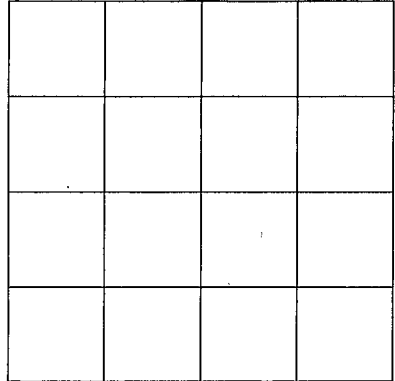

SECTION _____

Please indicate well location X.

ADDITIONAL INFORMATION

If more than one screen,
show location of each on sketch.