

STONE

AOI

2-5-62

WATER WELL DRILLERS LOG

CODED

Date: 2-5-62, 1962, Driller: Leo Sabert, County Stone
1804 (Name)

(1) Owner of Land: E W Davis
(Name)
Wiggins Miss
(Address)

(2) Location: 1/4, 1/4, Sec. 2 T 2 R 13
8 miles west of Wiggins
(distance) (direction) (Nearest Town)

(3) Topography: (Hilly) (Flat) (Level)

(4) Purpose of Well: Home Use
(Domestic Irrigation
Municipal, Industrial, Other)

Description & Color of Materials Sand, Clay, Red Clay, Shell, etc.	Thick- ness Feet	Depth Feet
Clay	6	0-6
Sand	6	6-12
Clay & Fine sand	15	12-27
dark clay	15	27-42
Fine Sand	40	42-82
sand & streaks of gravel	30	82-112
Course sand & gravel	12	112-124

Information upon completion of well:

(1) Diameter 2 inches.

(2) Total Depth 124 feet.

(3) Water Level 30 feet below top of ground.

(4) Cased to 119, Size 2"

(5) Screen: Size 1/10, Length 5'


(6) Were any formations sealed against pollution?
yes, no.

CODED

If YES depth of formation _____

Why _____

Drillers Remarks: _____

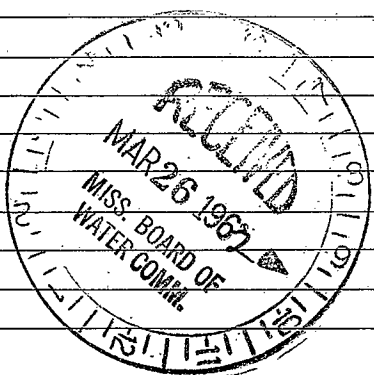

56 Well No.

(Use Back Side)

