

STONE

B5

10-5-60

WATER WELL DRILLERS LOG

~~B 300~~

Date: 10-5, 1960, Driller: Pannell Anderson County Stone
 (Name)

(1) Owner of Land: Mr. O. E. Batson Sr.
 (Name)
Wiggins Miss
 (Address)

(2) Location: SE 1/4, NE 1/4, Sec 32 T2R12
6 miles West, of Wiggins
 (distance) (direction) (Nearest Town)

(3) Topography: X
 (Hilly) (Flat) (Level)

(4) Purpose of Well: Domestic
 (Domestic Irrigation
 Municipal, Industrial, Other)

Description & Color of Materials Sand, Clay, Red Clay, Shell, etc.	Thick-ness Feet	Depth Feet
<u>Red clay</u>	<u>40</u>	
<u>Sand Clay the Rest of Way</u>		
<u>Sand & gravel at Bottom</u>	<u>14</u>	

Information upon completion of well:

(1) Diameter 2 inches.

(2) Total Depth 105 feet.

(3) Water Level 70 feet below top of ground.

(4) Cased to _____, Size _____

(5) Screen: Size 2" x 10^{slot}, Length 10'


(6) Were any formations sealed against pollution?
 _____ yes, _____ no.

If YES depth of formation _____

Why _____

Drillers Remarks: This is an all

P.V.C. Plastic, POINT
& Pipe.

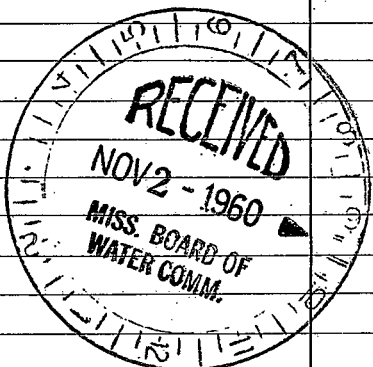

(Use Back Side)

Well No.

