

B8
8-17-61

WATER WELL DRILLERS LOG

CODED

Date: August 17, 1961, Driller: J. Lott H.M.S. County STONE
1443 (Name)

(1) Owner of Land: RICHARD POWE
(Name)
WIGGINS, MISS. Rt 2
(Address)

(2) Location: 1/4, 1/4, Sec. 22 T 2 R 12
5 miles West of Wiggins
(distance) (direction) (Nearest Town)

(3) Topography: ✓
(Hilly) (Flat) (Level)

(4) Purpose of Well: Domestic
(Domestic Irrigation
Municipal, Industrial, Other)

Description & Color of Materials Sand, Clay, Red Clay, Shell, etc.	Thick- ness Feet	Depth Feet
<u>0 - 40 - R.C</u>		
<u>40 - 50 - W.C</u>		
<u>50 - 86 - W.S</u>		
<u>10 - S</u>		
<u>58 To W</u>		
<u>73' Deep pipe</u>		

Information upon completion of well:

(1) Diameter 2 inches.

(2) Total Depth 86 feet.


(3) Water Level 58 feet below top of ground.

(4) Cased to 86 feet, Size 2".

(5) Screen: Size 2", Length 10 ft.

(6) Were any formations sealed against pollution?
yes, ✓ no.

CODED

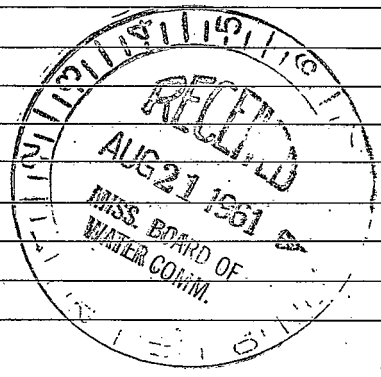

If YES depth of formation _____

Why _____

Drillers Remarks: _____

(Use Back Side)

Well No.

