

B/1
3-6-62

WATER WELL DRILLERS LOG

CODED

Date: MARCH 6, 1962, Driller: JAY LOTT ^{H.B.}
 County: STONE

¹³²¹
1322

(Name)

(1) Owner of Land: MARVIS W. FAIRLEY

(Name)

BOND, MISSISSIPPI

(Address)

(2) Location: 1/4, 1/4, Sec. 11 T2R12

3 miles NORTH of WIGGINS
 (distance) (direction) (Nearest Town)

(3) Topography: ✓
 (Hilly) (Flat) (Level)

(4) Purpose of Well: ✓
 (Domestic Irrigation) (Municipal, Industrial, Other)

| Description & Color of Materials Sand, Clay, Red Clay, Shell, etc. | Thick- ness Feet | Depth Feet |
|---|------------------------|---------------|
| <u>0-20- R-C</u> | | |
| <u>20-40- R-S</u> | | |
| <u>40-70- R-C</u> | | |
| <u>70-90- W-S</u> | | |
| <u>90-130- W-L</u> | | |
| <u>130-155- W-S</u> | | |
| <u>10 ft - S</u> | | |
| <u>67 ft W</u> | | |

Information upon completion of well:


- (1) Diameter 2 inches.
- (2) Total Depth 155 feet.
- (3) Water Level 67 feet below top of ground.
- (4) Cased to 67, Size 2
- (5) Screen: Size 2, Length 10
- (6) Were any formations sealed against pollution?
✓ yes, ✓ no.

If YES depth of formation _____

Why _____

Drillers Remarks: _____

CODED

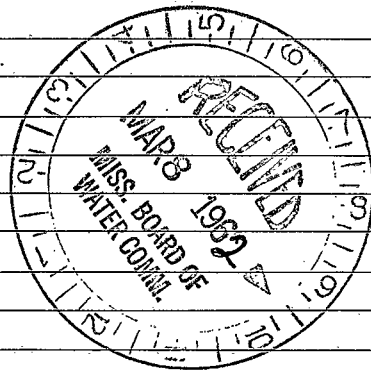

(Use Back Side)

Well No.

