

Stone
B 20
8-6-68
U.S.G.S.

MISSISSIPPI
BOARD OF WATER COMMISSIONERS
416 North State Street
Jackson, Mississippi 39201

CODED

WATER WELL DRILLERS LOG

8-6 1968 date well completed
Levitron Well Co. firm name
Stone county well located

LANDOWNER: New Zion Utility Association, College St. Wiggins, Miss.
(mailing address)

description of formations encountered

from

to

WELL LOCATION:
sec 23 T 2 N R 12 W
S W
1 miles W of WIGGINS
(distance) (direction) (nearest town)

coarse red sand 0 60

white sand 60 114

soft clay 114 142

mixed 142 168

clay 168 186

sand 186 330

clay 330 574

fine sand 574 607

shale 607 660

WELL PURPOSE: utility company
(home, irrigation, municipal, industrial)

mixed 660 680

sand 680 698

shale 698 702

WELL COMPLETION DATA:

good sand 702 766

shale 766 800

sand 800 841

- (1) diameter (inches) 6 x 8
(2) total depth (feet) 954
(3) static water level (feet) 165 below above top of ground.

fine sand 841 872

sand 872 910

shale 910 914

- (4) casing gal. steel, 914' (material) (depth)
8 x 6 if telescope see back. (size)

good sand ✓ 914 920

clay 920 922

good sand ✓ 922 954

clay 954 982

- (5) screen 40' (length) 914' (depth to top)
12 ga, SS on pipe (size) (material)

mixed 982 1010

clay 1010 1016

- (6) pump 20 (HP) 150 (yield gpm)
electric (type power)

CODED

- (7) electric log Yes (yes or no)
U.S.G.S (organization running log)

- (8) how well bottom plugged Back pressure valve

JAN 29 1968


DRILLERS REMARKS:

MISS. BD. OF
WATER COMMISSIONERS

(X)

If well telescopes please sketch and show depths.

GROUND LEVEL

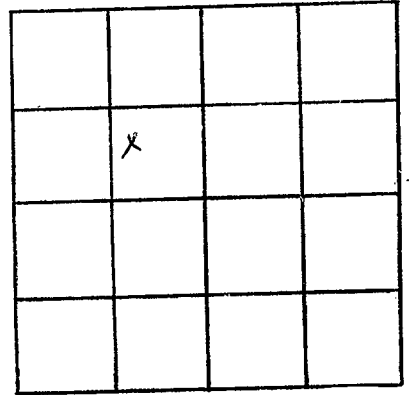

SECTION 23

Please indicate well location X.

ADDITIONAL INFORMATION

If more than one screen,
show locations of each on sketch.