

CODED

well no
146

STONE

B22

7-68

MISSISSIPPI
BOARD OF WATER COMMISSIONERS
416 North State Street
Jackson, Mississippi 39201

WATER WELL DRILLERS LOG

7-5

19 Moore, S. C. Water Well Service STONE

date well completed

firm name

county well located

LANDOWNER:

Edlio PETERS
Wiggins Ln SS
(mailing address)

description of formations encountered

from

to

Surface 0 22
BLUE SANDSTONE 22 85
Water SAND 85 119

WELL LOCATION:

sec. 22 T. 4 N. R. 14 E.
 18 S. W

_____ miles _____ of _____
(distance) (direction) (nearest town)

WELL PURPOSE: house
(home, irrigation, municipal, industrial)

WELL COMPLETION DATA:

(1) diameter (inches) 2"
(2) total depth (feet) 113
(3) static water level (feet) 30 below
top of ground: above

(4) casing 107
(material) (depth)

(size) if telescope see back.

(5) screen 6
(length) (depth to top)

(size) (material)

(6) pump 4-6 water
(HP) (field gpm)

54 feet
(type power)

(7) electric log NO
(yes or no)

(organization running log)

(8) how well bottom plugged _____


DRILLERS REMARKS:

100's Well Plumety
Water

APR 29 1968
MISS. BOARD OF
WATER COMMISSIONERS

If well telescopes please sketch and show depths.

GROUND LEVEL

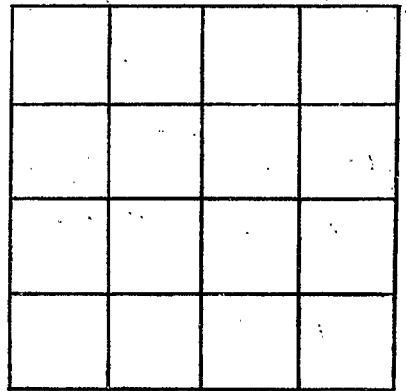

SECTION _____

Please indicate well location X.

ADDITIONAL INFORMATION

If more than one screen, show locations of each on sketch.