

Stone
B25
10-9-68

MISSISSIPPI
BOARD OF WATER COMMISSIONERS
416 North State Street
Jackson, Mississippi 39201

CODED CODED

CODED

CODED

WATER WELL DRILLERS LOG

10-9 1968 Parnell Anderson Stone
date well completed firm name county well located

LANDOWNER: Forest Beesley

description of formations encountered from to

Route 2 Box 139
Wiggins Miss
(mailing address)

Top Soil & Clay	0	15
Sand Fine	15	63
Red clay & fine sand str.	63	90
Fine Sand	90	115
Coarse Sand	115	126

WELL LOCATION:
sec. 18 T. 2 S. R. 12 W.
15 miles E of Wiggins
(distance) (direction) (nearest town)

WELL PURPOSE: Home
(home, irrigation, municipal, industrial)

WELL COMPLETION DATA:

- (1) diameter (inches) 2
- (2) total depth (feet) 126
- (3) static water level (feet) 40 below top of ground.
- (4) casing Plastic, 120 (material) (depth)
- (size) if telescope see back.
- (5) screen 6' 120 (length) (depth to top)
- 2" Plastic (size) (material)
- (6) pump 1/2 5 (HP) (yield gpm)
- E (type power)
- (7) electric log (yes or no)
- (organization running log)
- (8) how well bottom plugged Back Wash Valve

DRILLERS REMARKS:

CODED


CODED

DEED
MISS. REG. OF
MUNICIPAL WATER

MISS. REG. OF
MUNICIPAL WATER

If well telescopes please sketch and show depths.

GROUND LEVEL

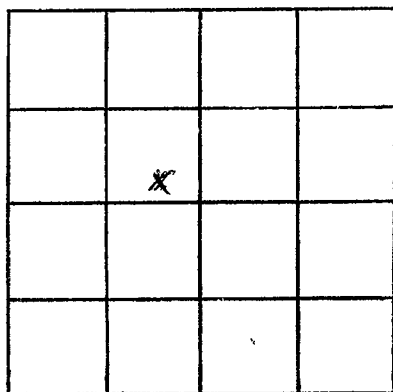

SECTION 18

Please indicate well location X.

ADDITIONAL INFORMATION

If more than one screen, show locations of each on sketch.