

CODED

320  
48.

MISSISSIPPI  
 BOARD OF WATER COMMISSIONERS CODED  
 416 North State Street  
 Jackson, Mississippi 39201

CODED

WATER WELL DRILLERS LOG

Stone  
 B26  
 9-17-68

9-17 1968 More Water Services STONE  
 date well completed firm name county well located

LANDOWNER: W.N. Moore Sr.  
BOND MISS.  
San Del.  
 (mailing address)

description of formations encountered	depth	
	from	to
<u>Sand</u>	<u>0</u>	<u>21</u>
<u>Sand &amp; clay</u>	<u>21</u>	<u>26</u>
<u>Clay</u>	<u>26</u>	<u>60</u>
<u>Sand, white color</u>	<u>60</u>	<u>90</u>
		<u>70</u>

WELL LOCATION:  
 sec. 11 T38 N R 12 W  
 S E W  
1 miles EAST of BOND  
 (distance) (direction) (nearest town)

WELL PURPOSE:  
 (home, irrigation, municipal, industrial)


WELL COMPLETION DATA:  
 (1) diameter (inches) 2"  
 (2) total depth (feet) 90  
 (3) static water level (feet) 50 below top of ground. 40 above  
 (4) casing PLAST. (material) (depth)  
 (size) if telescope see back.

(5) screen 6 (length) 84 (depth to top)  
2" (size) QUARTZ (material)

(6) pump MARIC (type power) (yield gpm)  
1 horse  
1 horse

(7) electric log NO (yes or no)  
 (organization running log)


(8) how well bottom plugged BAC 1 1/2  
Gravel 2"

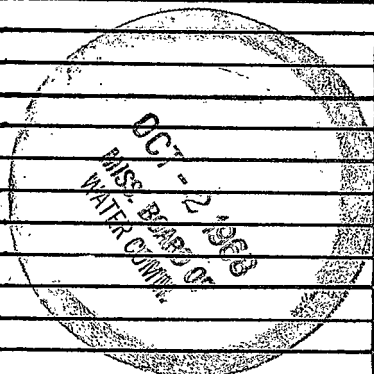

DRILLERS REMARKS: Purity of water  
6.3 inch 1" Plastic in  
S.P. & Get 1 1/4" top end  
1 foot Plast. To Pump. 1 1/4"

If well telescopes please sketch and show depths.

GROUND LEVEL

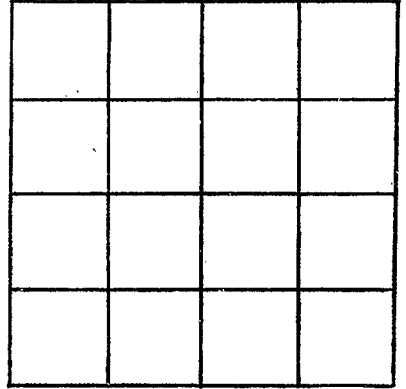

SECTION 11

Please indicate well location X.

ADDITIONAL INFORMATION

If more than one screen, show locations of each on sketch.