

CODED

CODED

CODED

CODED

Stone
B 27
10-68

MISSISSIPPI
BOARD OF WATER COMMISSIONERS
416 North State Street
Jackson, Mississippi 39201

WATER WELL DRILLERS LOG

19 Parnell Anderson

Stone

date well completed

firm name

county well located

LANDOWNER: Luis G. Hranjua

description of formations encountered

from

to

Wiggins Miss
Route 1
(mailing address)

<u>Red clay</u>	<u>10</u>	<u>14</u>
<u>White clay</u>	<u>14</u>	<u>30</u>
<u>Blue clay</u>	<u>30</u>	<u>200</u>
<u>Fine Sand</u>	<u>200</u>	<u>210</u>
<u>Blue clay</u>	<u>210</u>	<u>460</u>
<u>Fine SAND</u>	<u>460</u>	<u>478</u>
<u>Blue clay</u>	<u>478</u>	<u>490</u>
<u>Fine Sand</u>	<u>490</u>	<u>525</u>
<u>Blue clay</u>	<u>525</u>	<u>690</u>
<u>Coarse Sand</u>	<u>690</u>	<u>720</u>

WELL LOCATION:

sec. 18 T. 2 S. R. 12 W.
7 miles WEST of Wiggins
(distance) (direction) (nearest town)

WELL PURPOSE:

(home, irrigation, municipal, industrial)

WELL COMPLETION DATA:

(1) diameter (inches) 2

(2) total depth (feet) 720

(3) static water level (feet) 83 below above top of ground.

(4) casing Galo, 710,
(material) (depth)

(size) if telescope see back.

(5) screen 10, 710
(length) (depth to top)

2", Stainless Steel
(size) (material)

(6) pump 1, 8
(HP) (yield gpm)


Electric
(type power)

(7) electric log NO
(yes or no)

(organization running log)


(8) how well bottom plugged
Backwash Valve

DRILLERS REMARKS:

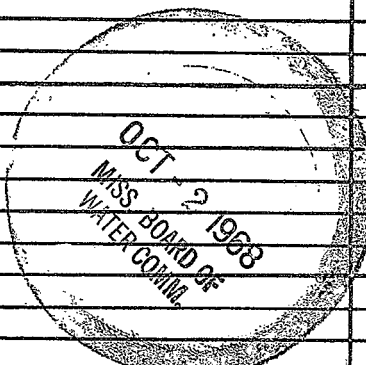

If well telescopes please sketch and show depths.

GROUND LEVEL

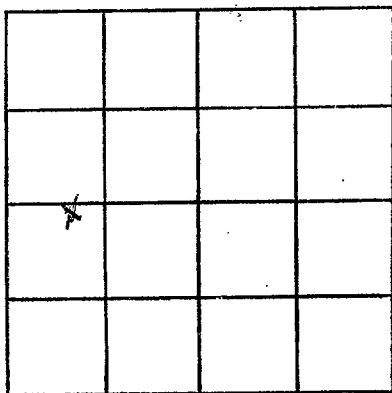

SECTION 18

Please indicate well location X.

ADDITIONAL INFORMATION

If more than one screen, show locations of each on sketch.