

Stone  
 B 28  
 9-5-68

MISSISSIPPI  
 BOARD OF WATER COMMISSIONERS  
 416 North State Street  
 Jackson, Mississippi 39201

INDEXED

WATER WELL DRILLERS LOG

9-5 1968 B W Smith Stone  
 date well completed firm name county well located

LANDOWNER:  
 Claud Chandler  
 Wiggins  
 (mailing address)

description of formations encountered	from	to
Top	0	2
Clay	2	8 1/2
Sand & Gravel	8 1/2	165

WELL LOCATION:  
 sec. 1 T. 2 S. R. 12 W.  
 2 miles @ N of Bond  
 (distance) (direction) (nearest town)

WELL PURPOSE:  
 (home, irrigation, municipal, industrial)

WELL COMPLETION DATA:

(1) diameter (inches) 9"

(2) total depth (feet) 150'

(3) static water level (feet) 96' below top of ground.

(4) casing Gal, 150' (material), (depth)

(size) If telescope see back.

(5) screen 3' (length), (depth to top)  
 2" Gal (size), (material)

(6) pump 1 (HP), 10 (yield gpm)  
 Electric (type power)

(7) electric log (yes or no)

(organization running log)

(8) how well bottom plugged B W

INDEXED


FEB 1 1968

MISS. BD. OF  
 WATER COMMISSIONERS

DRILLERS REMARKS:

If well telescopes please sketch and show depths.

GROUND LEVEL

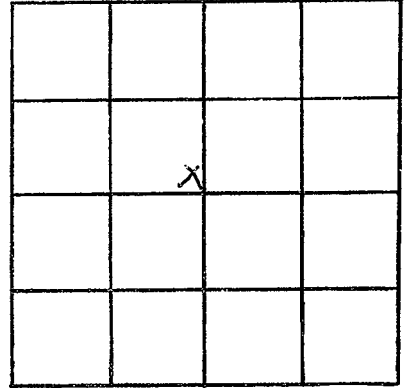

SECTION 1

Please indicate well location X.

ADDITIONAL INFORMATION

If more than one screen,  
show locations of each on sketch.