

STONE

B 29

2-5-69

MISSISSIPPI
 BOARD OF WATER COMMISSIONERS
 416 North State Street
 Jackson, Mississippi 39201

WATER WELL DRILLERS LOG

CODED

2-5

1969 Pernell Henderson

Stone

date well completed

firm name

county well located

LANDOWNER: Gulfport Creosoting
Coy Wiggins Miss

description of formations encountered

from to

TOP Soil	0	3
Clay	3	20
Sand + GRAU	20	31
Red clay	31	48
Fine Sand	48	63
Pink clay	63	70
Fine Sand	70	87
Coarse Sand	87	95

(mailing address)

WELL LOCATION:

sec. 11 T. 2 S. R. 12 W.
1 1/2 miles N of Wiggins
 (distance) (direction) (nearest town)

WELL PURPOSE: Industrial
 (home, irrigation, municipal, industrial)

WELL COMPLETION DATA:

- (1) diameter (inches) 2
- (2) total depth (feet) 95
- (3) static water level (feet) 65 below top of ground.
- (4) casing Plastic 90, (material), (depth),
 _____ if telescope see back.
 (size)
- (5) screen 5', 90 (length), (depth to top)
2", Plastic (size), (material)
- (6) pump 1, 10 (HP), (yield gpm)
Elect (type power)
- (7) electric log _____ (yes or no)

(organization running log)

(8) how well bottom plugged Backwash valve


DRILLERS REMARKS:

MAR 30 1969

MISS. Bd. of WATER COMMISSIONERS

If well telescopes please sketch and show depths.

GROUND LEVEL

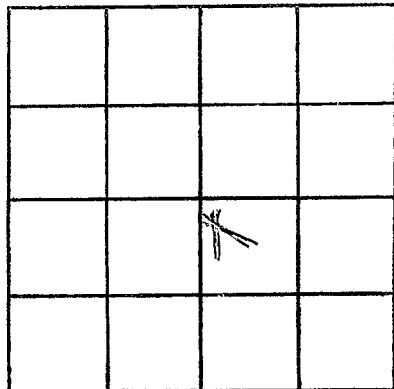

SECTION 11

Please indicate well location X.

ADDITIONAL INFORMATION

If more than one screen, show locations of each on sketch.