

CODED

Stone
B 30
7-12-69

MISSISSIPPI
BOARD OF WATER COMMISSIONERS
416 North State Street
Jackson, Mississippi 39201

WATER WELL DRILLERS LOG

7-12 1969 L W Smith Stone
date well completed firm name county well located

LANDOWNER:
Buford Smith
Perkinston
(mailing address)

description of formations encountered	from	to
Tab S	0	1
Clay	1	97
Sand	39	95

WELL LOCATION:
sec 26 T 2 S R 12 W
2 miles W of Perkinston
(distance) (direction) (nearest town)

WELL PURPOSE: GND
(home, irrigation, municipal, industrial)


- WELL COMPLETION DATA:
- (1) diameter (inches) _____
 - (2) total depth (feet) _____
 - (3) static water level (feet) 63 below top of ground
 - (4) casing Plastee 95 (material) (depth)
(size) if telescope see back.
 - (5) screen 5' 90' (length) (depth to top)
(size) (material)
 - (6) pump 1 14 (HP) (yield gpm)
(type power)
 - (7) electric log _____ (yes or no)
(organization running log)
 - (8) how well bottom plugged BW

DRILLERS REMARKS:

NOV 9 1969
MISS. ED. DE.
WATER COMM.

If well telescopes please sketch and show depths.

GROUND LEVEL

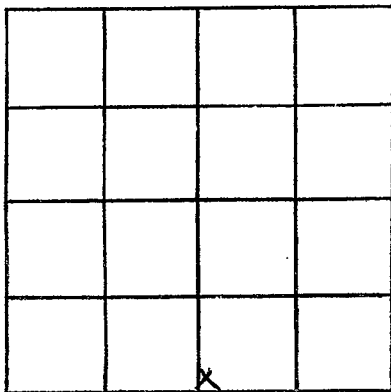

SECTION 26

Please indicate well location X.

ADDITIONAL INFORMATION

If more than one screen,
show locations of each on sketch.