

CODED

MISSISSIPPI
BOARD OF WATER COMMISSIONERS
416 North State Street
Jackson, Mississippi 39201

Stone
B 31
7-16-69

WATER WELL DRILLERS LOG

7-16 1969 date well completed
L. W. Smith firm name
Stone county well located

LANDOWNER:
Dorothy Breland
(mailing address)

description of formations encountered	from	to
Sandy	0	6
Clay	6	85
Sand	85	135

WELL LOCATION:
sec. 17 T 2 S R 12 W
4 miles W Wiggins
(distance) (direction) (nearest town)

WELL PURPOSE:
(home, irrigation, municipal, industrial)

- WELL COMPLETION DATA:
- (1) diameter (inches) 2
 - (2) total depth (feet) 135
 - (3) static water level (feet) 90 below above top of ground.
 - (4) casing Plastic, 135
(material) (depth)
(size) if telescope see back.
 - (5) screen 5 130
(length) (depth to top)
(size) (material)
 - (6) pump 1 8
(HP) (yield gpm)
E
(type power)
 - (7) electric log
(yes or no)
(organization running log)
 - (8) how well bottom plugged B.W.


DRILLERS REMARKS:

MAY 9 1969

MISS. BD. OF
WATER COMMISSIONERS

If well telescopes please sketch and show depths.

GROUND LEVEL

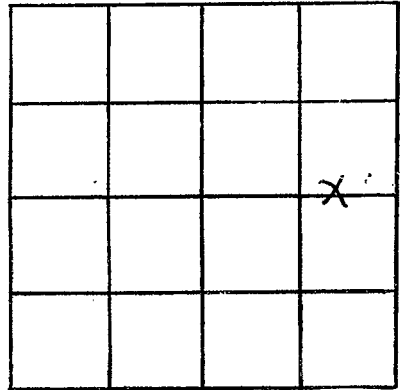

SECTION _____

Please indicate well location X.

ADDITIONAL INFORMATION

If more than one screen,
show locations of each on sketch.