

CODED

Stone
B 32
9-25-69

MISSISSIPPI
BOARD OF WATER COMMISSIONERS
416 North State Street
Jackson, Mississippi 39201

WATER WELL DRILLERS LOG

9-25 1969 date well completed
L W Smith firm name
Stone county well located

LANDOWNER:
Alban Lee
Wiggins
(mailing address)

| description of formations encountered | from | to |
|---------------------------------------|------|----|
| Top S | 0 | 1 |
| Clay | 1 | 37 |
| Sand | 37 | 95 |

WELL LOCATION:
sec. 26 T 2 N R 12 W
2 miles W of Wiggins
(distance) (direction) (nearest town)

WELL PURPOSE:
(home, irrigation, municipal, industrial)


- WELL COMPLETION DATA:
- (1) diameter (inches) 2
 - (2) total depth (feet) 95
 - (3) static water level (feet) 63 below above top of ground.
 - (4) casing Plastic, 95 (material) (depth)
 - (size) if telescope see back.
 - (5) screen 5' 90 (length) (depth to top)
 - (size) (material)
 - (6) pump 1 14 (HP) (yield gpm)
 - E (type power)
 - (7) electric log (yes or no)
 - (organization running log)
 - (8) how well bottom plugged BW

DRILLERS REMARKS:

MISS. BD. OF
WATER COM.

If well telescopes please sketch and show depths.

GROUND LEVEL

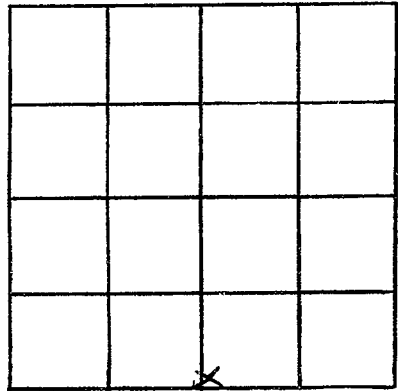

SECTION 26

Please indicate well location X.

ADDITIONAL INFORMATION

If more than one screen, show locations of each on sketch.