

STONE

B 34

2-9-68

MISSISSIPPI  
 BOARD OF WATER COMMISSIONERS  
 416 North State Street  
 Jackson, Mississippi 39201

**CODED**

WATER WELL DRILLERS LOG

2-9  
date well completed

1968 Leo Labret  
firm name

Stone  
county well located

LANDOWNER: Standard Oil Co

description of formations encountered

from to

JACKSON MISS  
(mailing address)

Surface	0	1
Red Clay	1	18
Red Sand	18	114
Sand & Gravel	114	129

WELL LOCATION:


sec 26 T     N R     E  
    S     W 12 W  
1 miles (distance) SW (direction) of Wiggins (nearest town)

WELL PURPOSE: SERVICE STATION  
(home, irrigation, municipal, industrial)

WELL COMPLETION DATA:

- (1) diameter (inches) 4"
- (2) total depth (feet) 129
- (3) static water level (feet) 66 below top of ground.
- (4) casing Galv. 124'  
(material) (depth)  
4"  
(size) if telescope see back.
- (5) screen 5' 124'  
(length) (depth to top)  
2" Stainless Steel  
(size) (material)
- (6) pump 1 25  
(HP) (yield gpm)  
Elec  
(type power)
- (7) electric log NO  
(yes or no)
- (organization running log)
- (8) how well bottom plugged BW Labret


**CODED**

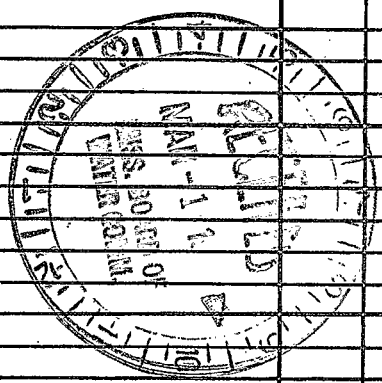

DRILLERS REMARKS:

If well telescopes please sketch and show depths.

GROUND LEVEL

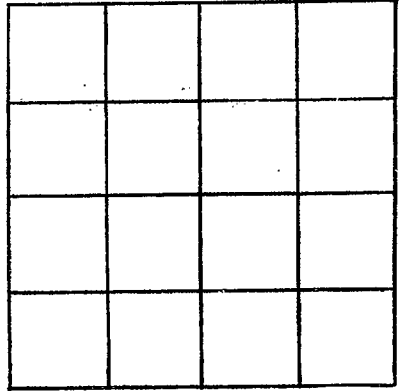

SECTION \_\_\_\_\_

Please indicate well location X.

ADDITIONAL INFORMATION

If more than one screen,  
show locations of each on sketch.