

STONE
B35
7-14-70

MISSISSIPPI
 BOARD OF WATER COMMISSIONERS
 416 North State Street
 Jackson, Mississippi 39201

CODED

WATER WELL DRILLERS LOG

7-14

1970 Parnell Anderson

Stone

date well completed

firm name

county well located

LANDOWNER: BURTON
Equipment Co
Wiggins
 (mailing address)

| description of formations encountered | from | to |
|---------------------------------------|-----------|-----------|
| <u>Topsoil</u> | <u>0</u> | <u>3</u> |
| <u>Red Clay</u> | <u>3</u> | <u>26</u> |
| <u>Fine Sand</u> | <u>26</u> | <u>31</u> |
| <u>Red Clay</u> | <u>31</u> | <u>39</u> |
| <u>Fine Sand with clay st.</u> | <u>39</u> | <u>68</u> |
| <u>Pink Clay</u> | <u>68</u> | <u>76</u> |
| <u>Fine Sand</u> | <u>76</u> | <u>81</u> |
| <u>Coarse Sand</u> | <u>81</u> | <u>90</u> |

WELL LOCATION:
 sec. 25 T. 2 S. R. 12 W.
1 miles W of Wiggins
 (distance) (direction) (nearest town)

WELL PURPOSE: INDUSTRIAL
 (home, irrigation, municipal, industrial)

- WELL COMPLETION DATA:
- (1) diameter (inches) 2
 - (2) total depth (feet) 90
 - (3) static water level (feet) 30 below top of ground.
 - (4) casing Plastic 84
 (material) (depth)
 (size) if telescope see back.
 - (5) screen 6 84
 (length) (depth to top)
24 Plastic
 (size) (material)
 - (6) pump 1 10
 (HP) (yield gpm)
Elect
 (type power)
 - (7) electric log _____
 (yes or no)
 (organization running log)
 - (8) how well bottom plugged
Backwash Valve

CODED


JUN 11 1971

MISS. BD. OF
 WATER COMM.

DRILLERS REMARKS:

If well telescopes please sketch and show depths.

GROUND LEVEL

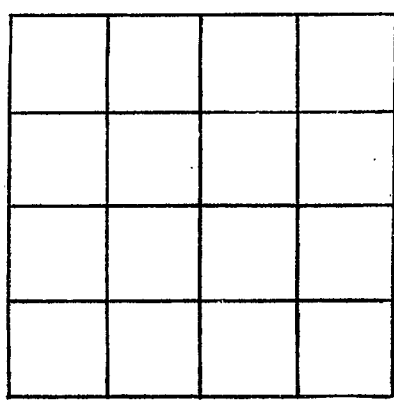

SECTION _____

Please indicate well location X.

ADDITIONAL INFORMATION

A series of horizontal lines for entering additional information.

If more than one screen, show locations of each on sketch.