

MISSISSIPPI  
BOARD OF WATER COMMISSIONERS  
416 North State Street  
Jackson, Mississippi 39201

**CODED**

WATER WELL DRILLERS LOG

STONE  
B 39  
1-17-72

1-17 date well completed 1972 Parwell Anderson firm name STONE county well located

LANDOWNER: Claude A. Walker

description of formations encountered

from to

Wiggins

Top Soil  
Sandy Red Clay  
Finesand  
Red Clay  
Coarse Sand

0 2  
2 28  
28 34  
34 46  
46 58

(mailing address)

WELL LOCATION:

sec. 25 T 2 S R 12 W  
2 miles W of Wiggins  
(distance) (direction) (nearest town)

WELL PURPOSE: Home  
(home, irrigation, municipal, industrial)

WELL COMPLETION DATA:

- (1) diameter (inches) 2
- (2) total depth (feet) 63
- (3) static water level (feet) 30 below top of ground.
- (4) casing Plastic, 58 (material) (depth)
- (size) if telescope see back.
- (5) screen 5, 58 (length) (depth to top)
- 2, Plastic (size) (material)
- (6) pump 1, 11 (HP) (yield gpm)
- Elect (type power)
- (7) electric log (yes or no)
- (organization running log)
- (8) how well bottom plugged Backwashable


**CODED**

DRILLERS REMARKS:

DEC 11 1972  
DEC 12 1972

If well telescopes please sketch and show depths.

GROUND LEVEL

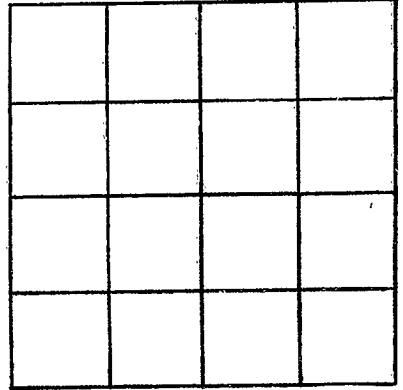

SECTION \_\_\_\_\_

Please indicate well location X.

ADDITIONAL INFORMATION

If more than one screen,  
show locations of each on sketch.