

STONE

B41

4-23-74

MISSISSIPPI BOARD OF WATER COMMISSIONERS
416 North State Street
Jackson, Mississippi 39201

CODED

WATER WELL DRILLERS LOG

4-23
date well completed

1974 Parnell Anderson
firm name

Stone
county well located

LANDOWNER:

Bertha Hollingsworth

description of formations encountered

Top Soil

from 0 to 4

Rt 1 Bond
(mailing address)

white clay 4 60

WELL LOCATION:

sec. 11 T. 2 S. R. 12 E.
1 miles N of Bond
(distance) (direction) (nearest town)

Blue clay 60 90

Coarse Sand 90 121

WELL PURPOSE: HOME
(home, irrigation, municipal, industrial)

WELL COMPLETION DATA:

- (1) diameter (inches) 2"
- (2) total depth (feet) 121'
- (3) static water level (feet) 66' below top of ground.
- (4) casing Plastic 116'
(material) (depth)

CODED


- (5) screen 5' 116'
(length) (depth to top)
2" Plastic
(size) (material)

- (6) pump 1 7
(HP) (yield gpm)
Elect
(type power)

- (7) electric log no
(yes or no)

(organization running log)

- (8) how well bottom plugged
Back wash valve

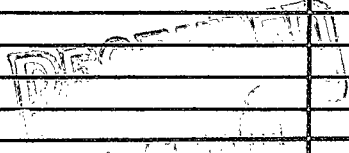

DRILLERS REMARKS:

