

STONE
B 42
5-29-74

MISSISSIPPI
BOARD OF WATER COMMISSIONERS
416 North State Street
Jackson, Mississippi 39201

CODED

WATER WELL DRILLERS LOG

5-29-74 date well completed
D. P. Anderson Stone firm name
Stone county well located

LANDOWNER:
S. J. Jackson
(mailing address)

WELL LOCATION:
sec. 7 T. 2 S. R. 12 E. W. 1
14 miles W of Wiggins
(distance) (direction) (nearest town)

WELL PURPOSE: HOME
(home, irrigation, municipal, industrial)

WELL COMPLETION DATA:
(1) diameter (inches) 2"
(2) total depth (feet) 65'
(3) static water level (feet) 30' below top of ground.
(4) casing Plastic 60' (material) (depth)
(size) if telescope see back.
(5) screen 5' 60' (length) (depth to top)
2" Plastic (size) (material)
(6) pump 1 10 (HP) (yield gpm)
Electric (type power)
(7) electric log no (yes or no)
(organization running log)
(8) how well bottom plugged P. Cugged


description of formations encountered	from	to
Top Soil	0	4
white clay	4	28
Blue clay	28	45
Coarse Sand	45	65

CODED

DRILLERS REMARKS:
MAY 6 1974
MISS. BD. OF WATER COMMISSIONERS

If well telescopes please sketch and show depths.

GROUND LEVEL

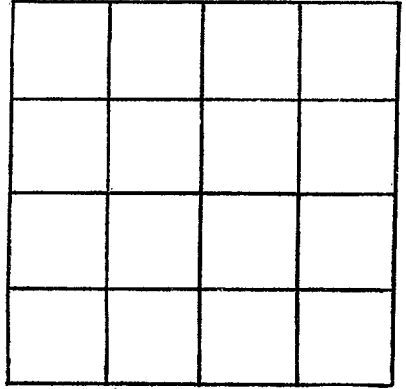

SECTION _____

Please indicate well location X.

ADDITIONAL INFORMATION

If more than one screen,
show locations of each on sketch.