

STONE
B 43
7-24-74

MISSISSIPPI
BOARD OF WATER COMMISSIONERS
416 North State Street
Jackson, Mississippi 39201

CODED

WATER WELL DRILLERS LOG

7-24 date well completed
1974 Darnell Anderson Stone firm name
Stone county well located

LANDOWNER:
Claude Chandler
(mailing address)

description of fomations encountered	from	to
Top Soil	0	4
Pink clay	4	35
sandy clay	35	41
fine sand	41	80
coarse sand	80	96

WELL LOCATION:
sec. 1 T. 2 S. R. 12 W.
1 miles E of Bond
(distance) (direction) (nearest town)

WELL PURPOSE: HOME
(home, irrigation, municipal, industrial)

- WELL COMPLETION DATA:
- (1) diameter (inches) 2"
 - (2) total depth (feet) 96'
 - (3) static water level (feet) 70' below top of ground.
 - (4) casing Plastic 91' (material) (depth)
 - (size) if telescope see back.
 - (5) screen 5' 91' (length) (depth to top)
 - 2" Plastic (size) (material)
 - (6) pump 1 (HP) 8 (yield gpm)
 - Elect (type power)
 - (7) electric log No (yes or no)
 - (organization running log)
 - (8) how well bottom plugged Plugged

CODED


RECEIVED

AUG - 2 1974

DRILLERS REMARKS:

If well telescopes please sketch and show depths.

GROUND LEVEL

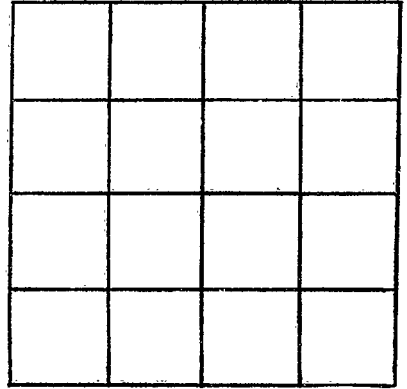

SECTION _____

Please indicate well location X.

ADDITIONAL INFORMATION

If more than one screen, show locations of each on sketch.