

STONE
B 44
10/30/74

MISSISSIPPI
BOARD OF WATER COMMISSIONERS
416 North State Street
Jackson, Mississippi 39201

CODED

WATER WELL DRILLERS LOG

10-30 19 Pam Anderson Stone
date well completed firm name county well located

LANDOWNER:
Metro Taylor
(mailing address)

description of formations encountered	from	to
<u>Top Soil</u>	<u>0</u>	<u>4</u>
<u>Red Clay</u>	<u>4</u>	<u>28</u>
<u>Sandy Clay</u>	<u>28</u>	<u>45</u>
<u>Gravel Sand</u>	<u>45</u>	<u>85</u>
<u>Coarse Sand</u>	<u>85</u>	<u>125</u>

WELL LOCATION:
sec 14 T 2 S R 12 E
W
1 miles W of Wlaga
(distance) (direction) (nearest town)

WELL PURPOSE: HOME
(home, irrigation, municipal, industrial)

WELL COMPLETION DATA:

(1) diameter (inches) 2"

(2) total depth (feet) 123'

(3) static water level (feet) 30' below top of ground.

(4) casing Plastic, 1 1/2"
(material) (depth)

(size) If telescope see back.

(5) screen 5' 1 1/2"
(length) (depth to top)

2" Plastic
(size) (material)

(6) pump 1 11
(HP) (yield gpm)

Elect
(type power)

(7) electric log no
(yes or no)

(organization running log)

CODED


(8) how well bottom plugged
Drilled

DRILLERS REMARKS:

RECEIVED
NOV 12 1974

If well telescopes please sketch and show depths.

GROUND LEVEL

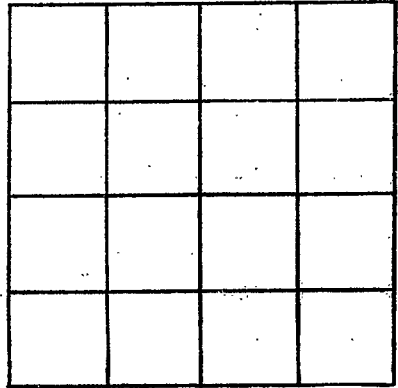

SECTION _____

Please indicate well location X.

ADDITIONAL INFORMATION

If more than one screen, show locations of each on sketch.