

STONE
B45
12-9-79

MISSISSIPPI
BOARD OF WATER COMMISSIONERS
416 North State Street
Jackson, Mississippi 39201

CODED

WATER WELL DRILLERS LOG

12-9 19 Barnell Anderson Stone
date well completed firm name county well located

LANDOWNER:
John McDonald

(mailing address)


description of formations encountered	from	to
Top Soil	0	3
white clay	3	44
coarse sand	44	55

WELL LOCATION:
sec. 26 T 2 N R 12 E
S W
1/2 miles S of Wiggin
(distance) (direction) (nearest town)

WELL PURPOSE: HOME
(home, irrigation, municipal, industrial)

- WELL COMPLETION DATA:
- (1) diameter (inches) 2"
 - (2) total depth (feet) 55'
 - (3) static water level (feet) 68' below top of ground.
 - (4) casing Plastic, 80'
(material) (depth)
 - (size) if telescope see back.
 - (5) screen 5', 80'
(length) (depth to top)
 - 2", Plastic
(size) (material)
 - (6) pump 1, 8
(HP) (yield gpm)
 - Elect
(type power)
 - (7) electric log no
(yes or no)
 - (organization running log)
 - (8) how well bottom plugged Plugged

CODED

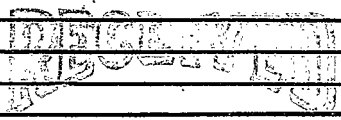

JAN 8 1975

DRILLERS REMARKS:

