

STONE
B46
2-17-75

MISSISSIPPI
 BOARD OF WATER COMMISSIONERS
 416 North State Street
 Jackson, Mississippi 39201

WATER WELL DRILLERS LOG

CODED

2-17 1975 Parnell Anderson Stone
 date well completed firm name county well located

LANDOWNER:
Dinkley Creans
 (mailing address)

description of formations encountered	from	to
<u>Top Soil</u>	<u>0</u>	<u>1/2</u>
<u>Red Clay</u>	<u>3</u>	<u>28</u>
<u>Hard Sand</u>	<u>38</u>	<u>42</u>
<u>Coarse Sand</u>	<u>42</u>	<u>105</u>

WELL LOCATION:
 sec. 14 T. 2 N. R. 12 E. 139
1 miles NW of W. Logan
 (distance) (direction) (nearest town)

WELL PURPOSE: HOME
 (home, irrigation, municipal, industrial)

WELL COMPLETION DATA:

(1) diameter (inches) 2"

(2) total depth (feet) 105'

(3) static water level (feet) 39 below above top of ground.

(4) casing Plastic, 100'
 (material) (depth)

(size) if telescope see back.

(5) screen 5' 100'
 (length) (depth to top)

2" Plastic
 (size) (material)

(6) pump 1 12
 (HP) (yield gpm)

Elect
 (type power)

(7) electric log no
 (yes or no)

(organization running log)

(8) how well bottom plugged
Back with rocks


CODED

REGISTERED
 MAR 13 1975

DRILLERS REMARKS:

If well telescopes please sketch and show depths.

GROUND LEVEL

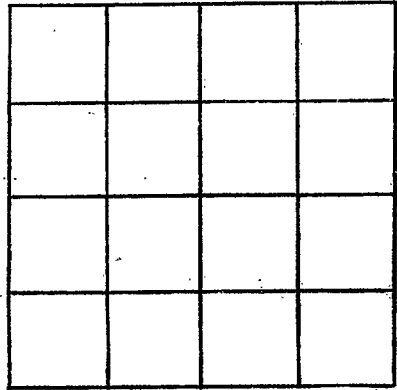

SECTION _____

Please indicate well location X.

ADDITIONAL INFORMATION

A series of horizontal lines for recording additional information.

If more than one screen, show locations of each on sketch.