

Stone
B 47
7-1-75

MISSISSIPPI
BOARD OF WATER COMMISSIONERS
416 North State Street
Jackson, Mississippi 39201

WATER WELL DRILLERS LOG CODED

7-1 1975 Pernell Anderson Stone
date well completed firm name county well located

LANDOWNER:	description of formations encountered	from	to
Charles Piazza	Top Soil	0	4
(mailing address)	fine sand	4	58
WELL LOCATION:	coarse sand	58	84
sec. 24 T 2 S R 12 W 132	fine sand	84	95
1 miles W of Wiggins	coarse sand	95	105
(distance) (direction) (nearest town)			
WELL PURPOSE: HOME			
(home, irrigation, municipal, industrial)			
WELL COMPLETION DATA:			
(1) diameter (inches) 2"			
(2) total depth (feet) 105'			
(3) static water level (feet) 59' below top of ground			
(4) casing Plastic 100'			
(material) (depth)			
(size) If telescope see back.			
(5) screen 5' 105'			
(length) (depth to top)			
2" Plastic			
(size) (material)			
(6) pump 1 11			
(HP) (yield gpm)			
Elect			
(type power)			
(7) electric log no			
(yes or no)			
(organization running log)			
(8) how well bottom plugged			
Plugged			
DRILLERS REMARKS:			

CODED


RECEIVED

AUG 4 1975

MISS. Bd. OF WATER COM.

If well telescopes please sketch and show depths.

GROUND LEVEL

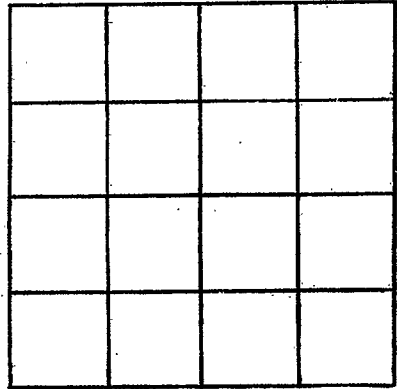

SECTION _____

Please indicate well location X.

ADDITIONAL INFORMATION

If more than one screen, show locations of each on sketch.