

State Well Report

Part 1

Mississippi Department of Environmental Quality
Office of Land and Water Resources
P.O. Box 10631
Jackson, MS 39289-0631
(601)961-5210
(601)354-6938 (fax)

County: Stone
Permit #: _____
Driller: Moore's Water Well Service
Date drilling completed: 2-9-06

For Office Use Only:
Aquifer: _____
Well #: B-66
L. S. Elevation: _____
E-log #: _____

State Law requires that this report be prepared by the driller in detail and filed with the Department within 30 days of completion of drilling of the well.

Well Owner Information	Well Location
Owner Name: <u>Norris Scott</u>	Latitude: _____ Longitude: _____
Mailing Address: <u>76 Pine Rd</u>	Method of Lat/Long (circle one): Conventional Survey, USGS quad, Hand-held GPS, Survey-grade GPS
<u>Wiggins MS 39577</u> City State Zip Code	<u>1/4 - 1/4 Sec 12 Twn 25 Rng 12W</u>
Telephone No. () _____	Distance Direction Nearest Town <u>5 Miles N of Wiggins</u>

Well Data

Purpose of Well (circle one) Home Industrial Public Supply Irrigation Fish Culture Other: _____

Date well drilling started: 2-7-06 Date well drilling completed: 2-9-06

If flowing, method of flow regulation: Valve _____ Other (describe) _____

Static Water Level: 42' feet above or below (circle one) land surface Date measured: 2-9-06

Method of Measurement (circle one) steel tape electric tape air line other: _____

Hole depth: 65' Well depth: 65' Well grouted to a depth of 10 feet

Type of grout (circle one): Cement Bentonite Mix

Casing length: 60 feet Casing diameter: 2 inches Type of casing: PVC

Screen length: 5 feet Screen diameter: 2 inches Type of screen: PVC

Screen slot size: .08 inches Setting depth: From 60 feet to 65 feet

Type of completion (circle all applicable): Gravel packed Underreamed Telescoped Open hole Natural Development
Other (describe): _____

Top of lap pipe or reduction in casing: _____ feet. If telescoped or more than one screen, describe on back of page

Logs run (circle all applicable): No log run Electric Gamma Ray Density Sonic Neutron Other: self-run

Name of organization running log(s): Moore's Water Well

I certify that the well was drilled, constructed, and completed in accordance with all applicable requirements of the Mississippi Department of Environmental Quality and/or the Mississippi Department of Health regulations and state laws.

Arnold Ray Moore 0533
Print Name of Water Well Contractor and License No.

Signature of Water Well Contractor

RECEIVED
MAR 10 2006
BY: OLWR

B-66


If well telescopes please sketch below and show depths.

Ground Level

Description of Formations Encountered	From	To
top soil	1'	2'
red sandy clay	2'	20'
white soapstone	20'	30'
white sand & pebbles	30'	65'

If more than one screen, show location of each on sketch

Sketch the property layout and include the following: 1) the well location; 2) any permanent structures on the property that may aid in locating the well; 3) any roads, power lines, or other items that may aid in locating the property and the well; 4) indicate direction.

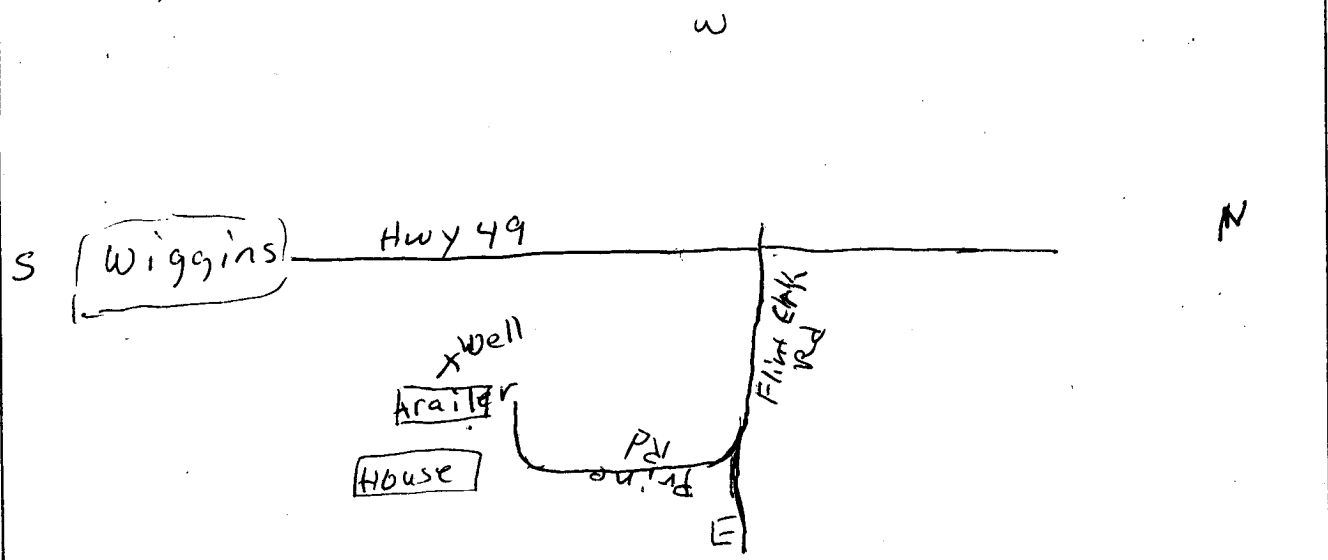

Landowner Name: Norris Scott

Signature of Water Well Contractor

RECEIVED
MAR 10 2006
BY: OLWR

STATE WELL REPORT

Part 2

Pump Installer's Completion Report
 Mississippi Department of Environmental Quality
 Office of Land and Water Resources
 P.O. Box 10631
 Jackson, MS 39289-0631
 (601)961-5210
 (601)354-6938 (fax)

County: Stone
 Permit #: _____
 Driller: Moore's Water Well Service
 Date completed: 2-9-06

For Office Use Only:

Aquifer: _____
 Well #: B-66
 Elevation: _____

This report should be prepared by the pump installer in detail and filed with the Department within 30 days of the installation of pump.

Well Owner Information	Well Location
Owner Name: <u>Norris Scott</u>	Latitude: _____ Longitude: _____
Mailing Address: <u>76 Princ Rd</u>	Method of Lat/Long (circle one): Conventional Survey, USGS quad, Hand-held GPS, Survey-grade GPS
<u>Wiggins, MS 39577</u>	_____ 1/4 _____ 1/4 Sec <u>12</u> Twn <u>2S</u> Rng <u>12W</u>
City State Zip Code	Distance Direction Nearest Town
Telephone No. (____) _____	<u>5</u> Miles <u>North</u> <u>Wiggins</u>

Pump Type Circle one	Power Type Circle one
Air Lift <input checked="" type="radio"/> Jet <input type="radio"/> Submersible	Diesel Engine <input type="radio"/> Gasoline Engine <input type="radio"/> Natural Gas
Bucket <input type="radio"/> Piston <input type="radio"/> Turbine	<input checked="" type="radio"/> Electric Motor <input type="radio"/> Hand <input type="radio"/> Tractor PTO
Centrifugal <input type="radio"/> Rotary <input type="radio"/> Flowing Well	Windmill <input type="radio"/> Other (specify): _____
Other (specify): _____	Horse Power Rating of Motor: <u>1 horse</u>
Date Pump Installed: <u>2-9-06</u>	Setting Depth: _____ feet
Rated Pump Capacity: <u>6</u> Gallons Per Minute	Number of Stages: <u>2</u>

Pump Test Data	Method of Measuring Water Level Circle one
Date Well Tested: <u>2-9-06</u>	Air Line <input type="radio"/> Electric Measuring Line <input type="radio"/> <input checked="" type="radio"/> Steel Tape
Static Water Level (A): <u>42</u> Feet Below Land Surface	Other (specify): _____
Pumping Water Level (B): _____ Feet Below Land Surface	For flowing well, measured shut in head: _____ feet
Drawdown [(B) - (A)]: _____ Feet Below Land Surface	Well yielded _____ GPM with a drawdown of _____ feet after _____ hours of pumping
Test Pumping Rate: <u>6</u> Gallons Per Minute	
Duration of Pump Test (minimum 4 hours): _____ hours	

I HEREBY CERTIFY that the above statements are true to the best of my knowledge.

Moore's Water Well Service 0533
 Print Name of Pump Installer and License No. (if applicable) Signature of Pump Installer

RECEIVED
 MAR 10 2006
 BY: OLWR