

# State Well Report

## Part 1

Mississippi Department of Environmental Quality  
Office of Land and Water Resources  
P.O. Box 10631  
Jackson, MS 39289-0631  
(601)961-5210  
(601)354-6938 (fax)

For Office Use Only:

Aquifer: B 88  
Well #: \_\_\_\_\_  
L. S. Elevation: \_\_\_\_\_  
E-log #: \_\_\_\_\_

County: Stone  
Permit #: \_\_\_\_\_  
Driller: AL HARRINGTON  
Date drilling completed: 9/30/09

State Law requires that this report be prepared by the driller in detail and filed with the Department within 30 days of completion of drilling of the well.

Well Owner Information	Well Location
Owner Name: <u>Tammy Small</u>	Latitude: <u>30° 52' 15"</u> Longitude: <u>89° 10' 48"</u>
Mailing Address: <u>Thelma Andrews Rd.</u>	Method of Lat/Long (circle one): <u>Conventional Survey</u>
<u>Wiggins MS 39577</u>	USGS quad, <u>Hand-held GPS</u> , Survey-grade GPS
City: _____ State: _____ Zip Code: _____	<u>SE 1/4 NW 1/4 Sec 15 Twn 25 Rng 12W</u>
Telephone No. ( ) _____	Distance: <u>3</u> Miles Direction: <u>NW</u> of Nearest Town: <u>Wiggins</u>

**Well Data**

Purpose of Well (circle one) Home Industrial Public Supply Irrigation Fish Culture Other: \_\_\_\_\_

Date well drilling started: 9/30/09 Date well drilling completed: 9/30/09

If flowing, method of flow regulation: Valve \_\_\_\_\_ Other (describe) \_\_\_\_\_

Static Water Level: 64.5' feet above or below (circle one) land surface Date measured: 9/30/09

Method of Measurement (circle one) steel tape electric tape air line other: \_\_\_\_\_

Hole depth: 136' Well depth: 136' Well grouted to a depth of 10' feet

Type of grout (circle one): Cement Bentonite Mix

Casing length: 126' feet Casing diameter: 4" inches Type of casing: PVC

Screen length: 10' feet Screen diameter: 4" inches Type of screen: PVC

Screen slot size: .008 inches Setting depth: From 1.26' feet to 136' feet

Type of completion (circle all applicable): Gravel packed Underreamed Telescoped Open hole Natural Development

Other (describe): \_\_\_\_\_

Top of lap pipe or reduction in casing: \_\_\_\_\_ feet. If telescoped or more than one screen, describe on back of page

Logs run (circle all applicable): No log run Electric Gamma Ray Density Sonic Neutron Other: \_\_\_\_\_

Name of organization running log(s): \_\_\_\_\_

I certify that the well was drilled, constructed, and completed in accordance with all applicable requirements of the Mississippi Department of Environmental Quality and/or the Mississippi Department of Health regulations and state laws.

AL HARRINGTON #0-564  
Print Name of Water Well Contractor and License No.


AL Harrington  
Signature of Water Well Contractor

RECEIVED  
OCT 20 2009  
BY: OLWR

If well telescopes please sketch below and show depths.

B 88

Ground Level

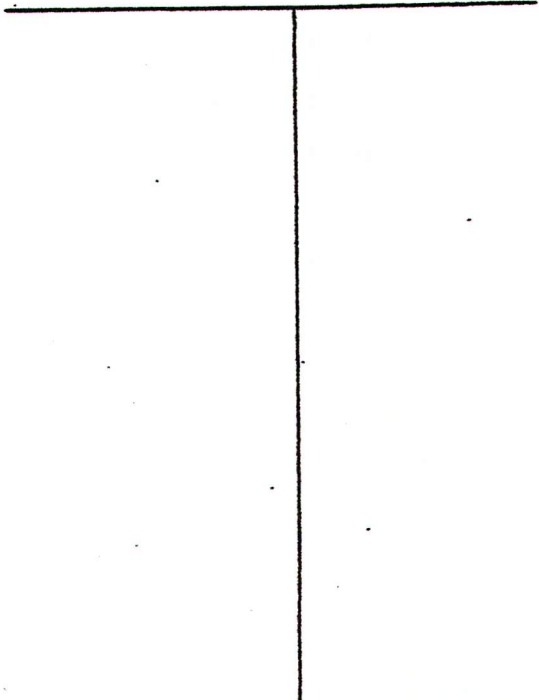


Description of Formations Encountered

From To

Description of Formations Encountered	From	To
Red Clay	0	20
Red Sand	20	60'
Sand & Clay	60'	110'
med orange & sand	110	136'

If more than one screen, show location of each on sketch

Sketch the property layout and include the following: 1) the well location; 2) any permanent structures on the property that may aid in locating the well; 3) any roads, power lines, or other items that may aid in locating the property and the well; 4) indicate direction.

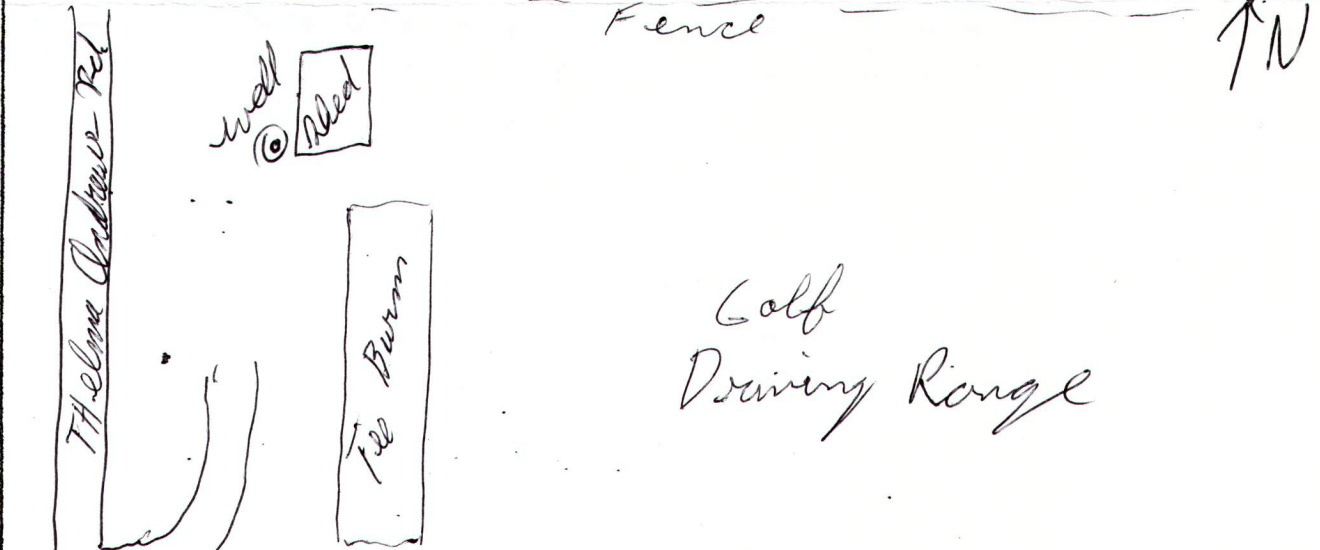

Landowner Name: Tommy Smell

Ol Harrington  
Signature of Water Well Contractor

RECEIVED  
OCT 20 2009  
BY: OLWR



# STATE WELL REPORT

## Part 2

**Pump Installer's Completion Report**  
 Mississippi Department of Environmental Quality  
 Office of Land and Water Resources  
 P.O. Box 10631  
 Jackson, MS 39289-0631  
 (601)961-5210  
 (601)354-6938 (fax)

For Office Use Only:

Aquifer: B 88  
 Well #: \_\_\_\_\_  
 Elevation: \_\_\_\_\_

County: Etane  
 Permit #: \_\_\_\_\_  
 Driller: AL HARRINGTON  
 Date completed: 9/30/09

This report should be prepared by the pump installer in detail and filed with the Department within 30 days of the installation of pump.

Well Owner Information	Well Location
Owner Name: <u>Tommy Small</u>	Latitude: <u>30°52'15"</u> Longitude: <u>-89°10'48"</u>
Mailing Address: _____ <u>Thelma Andrews Rd</u> <u>Wiggins MS 39577</u> City State Zip Code	Method of Lat/Long (circle one): Conventional Survey, USGS quad, <u>Hand-held GPS</u> , Survey-grade GPS <u>SE 1/4 NW 1/4 Sec 15 Twn 29 Rng 12W</u>
Telephone No. ( ) _____	Distance Direction Nearest Town <u>3 Miles NW of Wiggins</u>

Pump Type Circle one	Power Type Circle one
Air Lift Jet <input type="radio"/> <input checked="" type="radio"/> <u>Submersible</u>	Diesel Engine Gasoline Engine Natural Gas
Bucket Piston <input type="radio"/> Turbine <input type="radio"/>	<input checked="" type="radio"/> <u>Electric Motor</u> Hand <input type="radio"/> Tractor PTO
Centrifugal Rotary <input type="radio"/> Flowing Well <input type="radio"/>	Windmill Other (specify): _____
Other (specify): _____	Horse Power Rating of Motor: <u>1.5</u>
Date Pump Installed: <u>9/30/09</u>	Setting Depth: <u>90'</u> feet
Rated Pump Capacity: <u>20</u> Gallons Per Minute	Number of Stages: <u>206 P.M. units</u>

Pump Test Data	Method of Measuring Water Level Circle one
Date Well Tested: <u>9/30/09</u>	Air Line Electric Measuring Line <input checked="" type="radio"/> <u>Steel Tape</u>
Static Water Level (A): <u>64.5'</u> Feet Below Land Surface	Other (specify): _____
Pumping Water Level (B): <u>790'</u> Feet Below Land Surface	For flowing well, measured shut in head: _____ feet
Drawdown [(B) - (A)]: _____ Feet Below Land Surface	Well yielded _____ GPM with a drawdown of _____ feet after _____ hours of pumping
Test Pumping Rate: _____ Gallons Per Minute	
Duration of Pump Test (minimum 4 hours): _____ hours	

I HEREBY CERTIFY that the above statements are true to the best of my knowledge.

AL HARRINGTON #0-564  
 Print Name of Pump Installer and License No. (if applicable)

Al Harrington  
 Signature of Pump Installer

RECEIVED  
 OCT 20 2009  
 BY: OLWR