·	State Well	Report	For Office Use Only:		
county Stone	Part		0 89		
Missis	sippi Department of	Environmental Quality	Aquifer: <u> </u>		
Permit #:	Office of Land and Water Resources P.O. Box 10631		Well #:		
Driller UST WITCH WOIDNY.	Jackson, MS 39289-0631		L. S. Elevation:		
Date drilling completed: 1-11-10	(601) 961 (601) 354-69		E-log #:		
State Law requires that this report be a 30 days of completion of drilling of the	prepared by the dril well.	ller in detail and filed w	ith the Department within		
Well Owner Information			Location		
Owner Name Hemphill Constructi		Latitude: <u>30 • 49 ,913</u> ." Longitude <u>087 • 09 ,839</u> ."			
Mailing Address: P.O. Drawer	<u>879</u> м	Method of Lat/Long (circle one): Conventional Survey,			
			GPS, Survey-grade GPS		
Florence, Ms 3 City State	9073 5	10 1/ Sto 1/4 Sec 25	TwiT2S Rng RIZW		
	· .	SE NW 35 stance Direction	Nearest Town		
Telephone No. (401) 750-3156		Miles	Nearest Town of <u>(), 991, 5</u>		
hannen ha	Well Data				
Purpose of Well (circle one) Home Industrial	Public Supply Irr	igation Fish Culture	Other: OFFICE		
Date well drilling started: 1-11-10 Date well drilling completed: 1-11-10					
If flowing, method of flow regulation: Valve	A Other (descri	ibe)			
Static Water Level: <u>60</u> feet above or 6	elow(circle one) land	surface Date measured:	1-11-10		
Method of Measurement (circle one) steel tape	electric tape	air line other:			
Hole depth: 187FT Well depth: 187FT Well grouted to a depth of 10 feet					
Type of grout (circle one): Cement Bento		,			
Casing length:feet Casing diame	ter: <u> </u>	ches Type of casing:	NC		
Screen length: <u>10</u> feet Screen diameter: <u>2</u> inches Type of screen: <u>PVC</u>					
Screen slot size: <u>•000</u> inches Setting depth: From <u>177</u> feet to <u>187</u> feet					
Type of completion (circle all applicable): Grave	packed Underream	ed Telescoped Open !	hole Natural Development		
Other	(describe):				
Top of lap pipe or reduction in casing:	feet. If telesco	ped or more than one scre	en, describe on back of page		
Logs run (circle all applicable) No log run Elect	ric Gamma Ray De	nsity Sonic Neutron (Dther:		
Name of organization running log(s): N/A I certify that the well was drilled, constructed, as	nd completed in accor	dance with all applicable	requirements of the Mississinni		
Department of Environmental Quality and/or th					
Jack Ridgdell 0-472	2	Sed la	Iden		
Print Name of Water Well Contractor and License	No.	Signature of V	Water Well Contractor		
		· · · · · · · · · · · · · · · · · · ·	FEB 0 1 2010		

BY: OLWR

4

B 8'

From

To

- C Reservations Encounte

If well telescopes please sketch below and show depths.


Ground Level

۰.

1	Description of Formations Encountered	From	10
evel	TOPSOIL		2
	pranaeclay	3	15
	prange Coarse Sand	115	asi
		25	45
		45	57
	prange Coarse Sana	57	20
	brange clay	80	123
	Blue Clay	100	/ 응극
	Brown Coarse Sand W/Reagrave	163	ШЦ
			
		┼───┤	
		↓	
			
		11	
		I	J

· . . .

If more than one screen, show location of each on sketch

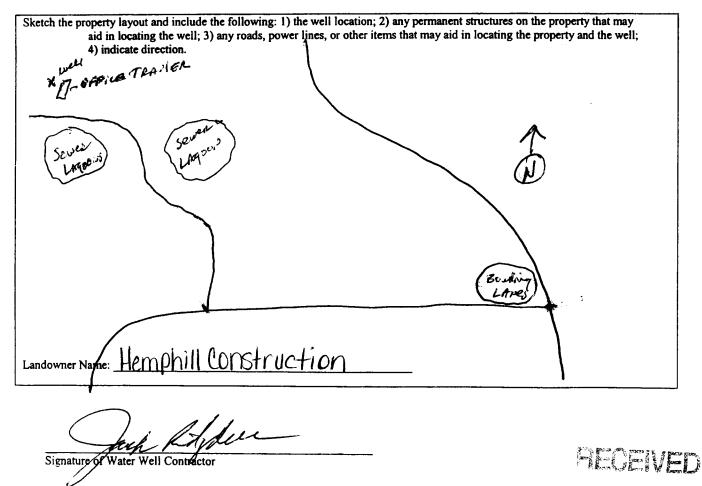

FEB 0 1 2010 BY: OLWR

$\xi_{\rm e} = e^{i \omega} t$	STATE W	ELL REPORT		
County: Stone Permit #: Driller COSt Water Well SRV	Part 2 Pump Installer's Completion Report Mississippi Department of Environmental Quality Office of Land and Water Resources P.O. Box 10631 Jackson, MS 39289-0631 (501) 961 5210		For Office Use Only: Aquifer: 39 Well #:	
Date completed: 1-11-10	(601) 961-5210 (601) 354-6938 (fax)		Elevation:	
This report should be prepared by t	he pump installer in det	ail and filed with the Departme	ent within 30 days of the	
installation of pump. Well Owner Informa	tion		Location	
Owner Name: Hemphill Construction		Latitude: 3549'912"	Longitude 087° 09' 829"	
Mailing Address: P.D. Drawer 879		Method of Lat/Long (circle one): Conventional Survey,		
			I-held GPS Survey-grade GPS	
Florence MS 39073 City State Zip Code		<u> %</u> % Sec 28	Twn T25 Rng R12W	
		Distance Direction Nearest Town		
Telephone No. 601, 750-3156		Miles IN of Wigging		
Ритр Туре	<u> </u>		wer Type ircle one	
Circle one	Submersible		ne Engine Natural Gas	
Bucket Piston	Turbine	Electric Motor Hand	Tractor PTO	
Centrifugal Rotary	Flowing Well		(specify):	
Other (specify):	Ũ	Horse Power Rating of Motor:		
Date Pump Installed: 1-12-10		Setting Depth: 80FT. Drop pipe feet		
Rated Pump Capacity:75	_Gallons Per Minute	Number of Stages:2	· · ·	
Pump Test Data			asuring Water Level	
Date Well Tested: 1-12-10			ircle one	
Static Water Level (A):Feet Below Land Surface		Air Line Electric Meas Other (specify):		
Pumping Water Level (B): <u>NA</u> Feet	Below Land Surface	Outer (specify).	1	
Drawdown [(B) – (A)]: Feet Below Land Surface		For flowing well, measured sh	ut in head: <u>N/A</u> feet	
Test Pumping Rate: 7.5 Gallons Per Minute		Well yielded <u>20</u>		
Duration of Pump Test (minimum 4 hours):	hours	feet after	NLA_hours of pumping	
HEREBY CERTIFY that the above statem	ents are true to the best o	f my knowledge	1	
Jack Ridgdell O-1 Print Name of Pump Installer and License N	+72	Signature of Pumpins	fece staller	
		0	FEB 0 1 20	
			87:01	

• • •