

Stone
B 2000
8-28-68

MISSISSIPPI
BOARD OF WATER COMMISSIONERS
416 North State Street
Jackson, Mississippi 39201

WATER WELL DRILLERS LOG

date well completed 19 68 Hattiesburg Butane firm name STONE county well located
Honer Evans

LANDOWNER: ~~Jones~~

description of formations encountered

from to

Wiggins, Miss,

<u>red clay</u>	<u>0-18</u>
<u>white sand + gravel</u>	<u>18-25</u>
<u>white clay</u>	<u>25-61</u>
<u>blue clay</u>	<u>61-163</u>
<u>blue sand</u>	<u>163-196</u>

(mailing address)

WELL LOCATION:

sec. 17 T. 2 N. R. 12 E.
S. W.
4 1/2 miles West of Wiggins
(distance) (direction) (nearest town)


WELL PURPOSE:
(home, irrigation, municipal, industrial)

OK
OK

WELL COMPLETION DATA:

- (1) diameter (inches) 2"
- (2) total depth (feet) 190'
- (3) static water level (feet) 84 below above top of ground.
- (4) casing galv, 190,
(material) (depth)
2 if telescope see back.
(size)
- (5) screen 10, 84
(length) (depth to top)
2", BRONZE
(size) (material)
- (6) pump 1, 400
(HP) (yield gpm)
electric
(type power)
- (7) electric log NO
(yes or no)
NO
(organization running log)
- (8) how well bottom plugged
BACK WASH VALVE

DRILLERS REMARKS:

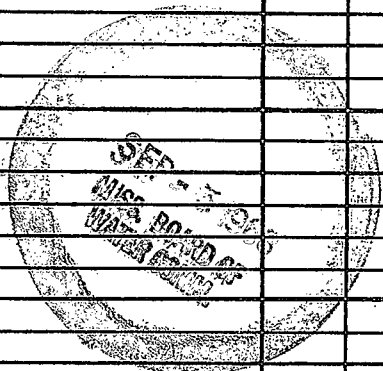

If well telescopes please sketch and show depths.

GROUND LEVEL

SECTION _____

Please indicate well location X.

ADDITIONAL INFORMATION

If more than one screen,
show locations of each on sketch.