

Stone
B 2001
6-20-76

MISSISSIPPI
BOARD OF WATER COMMISSIONERS
416 North State Street
13a Jackson, Mississippi 39201

WATER WELL DRILLERS LOG

6-20
date well completed

1976 *Parrell Anderson*
firm name

Stone
county well located

LANDOWNER:
Markel B Ireland
(mailing address)
WELL LOCATION:
sec *22* T. *2* N. R. *12* W. S. *3 1/4* miles *W* of *Wagon*
(distance) (direction) (nearest town)

description of formations encountered	from	to
<i>Top Soil</i>	<i>0</i>	<i>4</i>
<i>Clay</i>	<i>4</i>	<i>22</i>
<i>Hard Sand</i>	<i>22</i>	<i>61</i>
<i>Coarse Sand</i>	<i>61</i>	<i>85</i>

WELL PURPOSE: *HOME*
(home, irrigation, municipal, industrial)

WELL COMPLETION DATA:
(1) diameter (inches) *2 1/2*
(2) total depth (feet) *85*
(3) static water level (feet) *55* below top of ground
(4) casing *Plastic* *80*
(material) (depth)
If telescope see back:
(size) *5'* *80'*
(5) screen (length) (depth to top)
2" *Plastic*
(size) (material)
(6) pump *1* *10*
(HP) (yield gpm)
Elect
(type power)
(7) electric log *no*
(yes or no)
(organization running log)

(8) how well bottom plugged
Backwash Valve

DRILLERS REMARKS:


RECEIVED

JUL - 2 1976

MISS. BD. OF WATER COMM

If well telescopes please sketch and show depths.

GROUND LEVEL

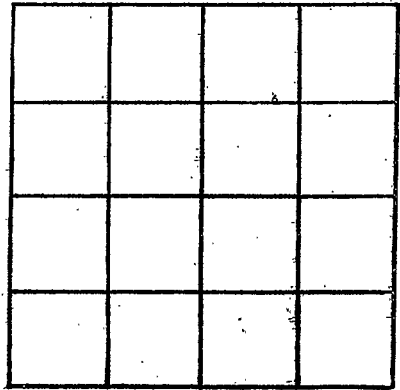

SECTION _____

Please indicate well location X.

ADDITIONAL INFORMATION

If more than one screen,
show locations of each on sketch.