

Stone  
B 2002  
7-20-76

MISSISSIPPI  
BOARD OF WATER COMMISSIONERS  
416 North State Street  
130 Jackson, Mississippi 39201

WATER WELL DRILLERS LOG

7-20  
date well completed

130 Penell Robinson  
firm name

Stone  
county well located


LANDOWNER:	description of formations encountered	from	to
O. E. Batson	Top Soil	0	4
(mailing address)	Red Clay	4	48
WELL LOCATION:	Fine Sand	48	55
sec 32 T 2 S R 13 W	White Clay	55	62
5 miles W of Wiggins	Fine Sand	62	76
(distance) (direction) (nearest town)	Coarse Sand	76	105
WELL PURPOSE: HOME			
(home, irrigation, municipal, industrial)			
WELL COMPLETION DATA:			
(1) diameter (inches) 2"			
(2) total depth (feet) 105'			
(3) static water level (feet) 65' below top of ground			
(4) casing Plastic 100' (material) (depth)			
(size) if telescope see back.			
(5) screen 5' 100' (length) (depth to top)			
2" Plastic (size) (material)			
(6) pump 1 (HP) 7 (yield gpm)			
Elect (type power)			
(7) electric log NO (yes or no)			
(organization running log)			
(8) how well bottom plugged Capped			
DRILLERS REMARKS:			

RECEIVED  
AUG 6 - 1976

MISS. BD. OF WATER

If well telescopes please sketch and show depths.

GROUND LEVEL

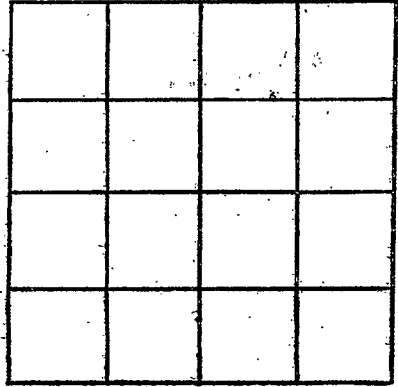

SECTION \_\_\_\_\_

Please indicate well location X.

ADDITIONAL INFORMATION

If more than one screen, show locations of each on sketch.