

Stone
Book
10/13/76

MISSISSIPPI
BOARD OF WATER COMMISSIONERS
416 North State Street
Jackson, Mississippi 39201

WATER WELL DRILLERS LOG

10-13
date well completed

132
firm name
Parnell Anderson

Stone
county well located


LANDOWNER:	description of formations encountered	from	to
Ronnie Lawrence	Top Soil	0	2
(mailing address)	Sandy clay	2	18
WELL LOCATION:	Blue Clay	18	149
sec. 31 T 2 N R 12 E S W 6 miles W of Wiggins (distance) (direction) (nearest town)	Course Sand	149	160
WELL PURPOSE: HOME (home, irrigation, municipal, industrial)			
WELL COMPLETION DATA:			
(1) diameter (inches) 2"			
(2) total depth (feet) 160'			
(3) static water level (feet) 38 below top of ground.			
(4) casing (material) Plastic, (depth) 155'			
(size) If telescope see back.			
(5) screen (length) 5' (depth to top) 155'			
(size) 2" (material) Plastic			
(6) pump (HP) 1/2 (yield gpm) 5			
Elect (type power)			
(7) electric log (yes or no) No			
(organization running log)			
(8) how well bottom plugged Capped			
DRILLERS REMARKS:			

RECEIVED
NOV - 1 1976

MISS. BD. OF WATER COMMISSIONERS

If well telescopes please sketch and show depths.

GROUND LEVEL

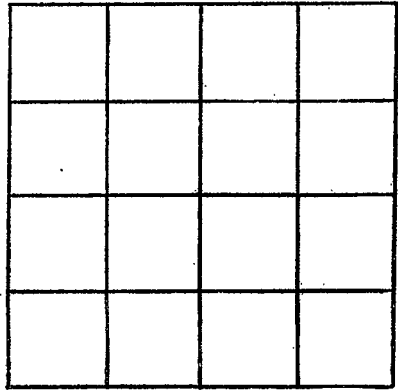

SECTION _____

Please indicate well location X.

ADDITIONAL INFORMATION

If more than one screen,
show locations of each on sketch.