

Stone  
B 2005  
1-25-77

MISSISSIPPI  
BOARD OF WATER COMMISSIONERS  
416 North State Street  
Jackson, Mississippi 39201

WATER WELL DRILLERS LOG

1-25-77  
date well completed

130 Parnell Anderson  
firm name

Stone  
county well located

LANDOWNER:  
Texas King  
(mailing address)

description of formations encountered	from	to
Top Soil	0	3
Sandy Clay	3	35
Flint Sand	35	66
Coarse Sand	66	85

WELL LOCATION:  
sec. 25 T 2 R 12 S 2 W  
1 miles S of Wlugh  
(distance) (direction) (nearest town)

WELL PURPOSE: HOME  
(home, irrigation, municipal, industrial)

WELL COMPLETION DATA:

(1) diameter (inches) 2"

(2) total depth (feet) 85'

(3) static water level (feet) 54 below top of ground

(4) casing Plastic 80' (material) (depth)  
If telescope see back. (size)

(5) screen 57' 80' (length) (depth to top)  
2" Plastic (size) (material)

(6) pump 1 (HP) 9 (yield gpm)  
C.lect (type power)

(7) electric log no (yes or no)  
(organization running log)

(8) how well bottom plugged  
Capped

DRILLERS REMARKS:


RECEIVED

FEB 1 1977

MISS. BD. OF WATER

If well telescopes please sketch and show depths.

GROUND LEVEL

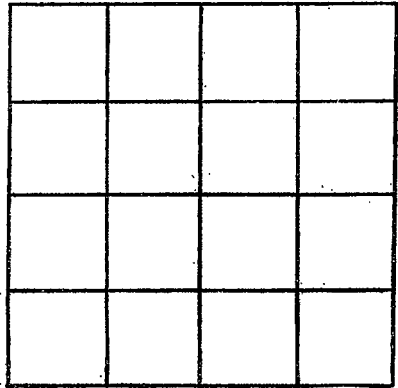

SECTION \_\_\_\_\_

Please indicate well location X.

ADDITIONAL INFORMATION

If more than one screen, show locations of each on sketch.