

STONE  
 B 2000  
 7-19-77

MISSISSIPPI  
 BOARD OF WATER COMMISSIONERS  
 416 North State Street  
 132 Jackson, Mississippi 39201

WATER WELL DRILLERS LOG

7-19-77 date well completed  
 1977 Pennell Anderson Stone firm name  
 Stone county well located


LANDOWNER:	description of formations encountered	from	to
Joe Blankship  (mailing address)			
WELL LOCATION: sec. 15 T 3 N R 12 E 2 1/2 miles W of Park (distance) (direction) (nearest town)	Clay	3	28
WELL PURPOSE: HOME (home, irrigation, municipal, industrial)	Coarse Sand	28	45
WELL COMPLETION DATA: (1) diameter (inches) 2" (2) total depth (feet) 65' (3) static water level (feet) 45' below top of ground. (4) casing Plastic, 60' (material) (depth) (size) if telescope see back. (5) screen 5' 60' (length) (depth to top) 2" Plastic (size) (material) (6) pump 1 6 (HP) (yield gpm) Elect (type power) (7) electric log No (yes or no) (organization running log) (8) how well bottom plugged Capped	Clay	45	58
	Fin D Sand	58	65
DRILLERS REMARKS:			

RECEIVED  
 AUG 5 1977

MISS. BD. OF WATER COMMISSIONERS

If well telescopes please sketch and show depths.

GROUND LEVEL

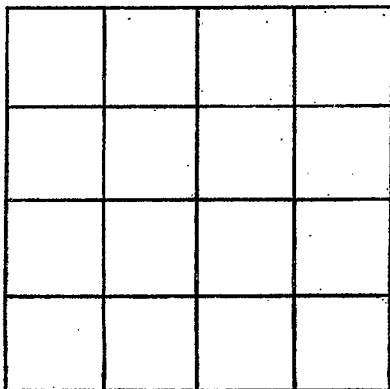

SECTION \_\_\_\_\_

Please indicate well location X.

ADDITIONAL INFORMATION

If more than one screen, show locations of each on sketch.