

STONE
B 2007
8-22-77

MISSISSIPPI
BOARD OF WATER COMMISSIONERS
416 North State Street
130 Jackson, Mississippi 39201

WATER WELL DRILLERS LOG

8-22 date well completed 1977 firm name Stone county well located

LANDOWNER: Bobby Beagon
description of formations encountered: Top Soil from 0 to 2
Best Clay 2 to 14
Course Sand 14 to 109
(mailing address)

WELL LOCATION: sec 25 T 2 N R 12 W S
1/2 miles W of Wiggins
(distance) (direction) (nearest town)

WELL PURPOSE: HOME
(home, irrigation, municipal, industrial)

- WELL COMPLETION DATA:
- (1) diameter (inches) 2"
 - (2) total depth (feet) 109
 - (3) static water level (feet) 51' below top of ground
 - (4) casing Plastic, 102' (material) (depth)
 - (size) If telescope see back.
 - (5) screen 3" 102' (length) (depth to top)
 - 2" Plastic (size) (material)
 - (6) pump 2 (HP) 10 (yield gpm)
 - Elect (type power)
 - (7) electric log no (yes or no)
 - (organization running log)
 - (8) how well bottom plugged Capped


DRILLERS REMARKS:

RECEIVED
SEP - 2 1977

MISS. Bd. OF WATER

If well telescopes please sketch and show depths.

GROUND LEVEL

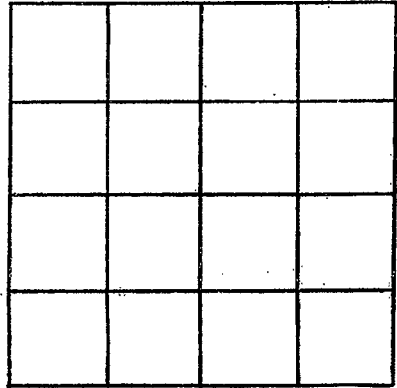

SECTION _____

Please indicate well location X.

ADDITIONAL INFORMATION

If more than one screen, show locations of each on sketch.