

Stone
B 2008
9/6/77

MISSISSIPPI
BOARD OF WATER COMMISSIONERS
416 North State Street
Jackson, Mississippi 39201


WATER WELL DRILLERS LOG

7-6 1977 Garnell Anderson Stone
date well completed firm name county well located

LANDOWNER:	description of formations encountered	from	to
Richard Diaz (mailing address)	Top Soil	0	3
WELL LOCATION: sec. <u>25</u> T. <u>2</u> N. R. <u>12</u> W miles _____ of _____ (distance) (direction) (nearest town)	Pink Clay	3	48
WELL PURPOSE: <u>HOME</u> (home, irrigation, municipal, industrial)	Covered Land	48	105
WELL COMPLETION DATA: (1) diameter (inches) <u>2"</u> (2) total depth (feet) <u>105'</u> (3) static water level (feet) <u>48'</u> below top of ground. (4) casing <u>Plastic 100'</u> (material) (depth) (size) If telescope see back. (5) screen <u>5' 100'</u> (length) (depth to top) <u>2"</u> (size) <u>Plastic</u> (material) (6) pump <u>1</u> (HP) <u>11</u> (yield gpm) <u>Elect</u> (type, power) (7) electric log <u>no</u> (yes or no) (organization running log) (8) how well bottom plugged <u>Capped</u>			
DRILLERS REMARKS:	<p style="text-align: center;">RECEIVED</p> <p style="text-align: center;">NOV - 6 1977</p>		

If well telescopes please sketch and show depths.

GROUND LEVEL

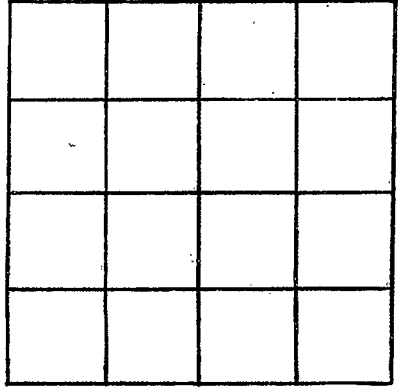

SECTION _____

Please indicate well location X.

ADDITIONAL INFORMATION

If more than one screen, show locations of each on sketch.