

STONE
B 2007
9-13-77

MISSISSIPPI C. P. CLARK
BOARD OF WATER COMMISSIONERS WELL DRILLING
416 North State Street ROUTE 2
13a Jackson, Mississippi 39201 AUREL, MISS. 39440

WATER WELL DRILLERS LOG

9/13 1977 O.P. Clark Stone
date well completed firm name county well located

LANDOWNER: L.M.F. #2
Box 490
Wiggins Ms. 39577
(mailing address)

description of formations encountered	from to	
	feet	feet
Red Clay	0	13
Red + Pink sand	13	66
Sand + Red gravel	66	128
Clay	128	131

WELL LOCATION:
sec. 26 T 2 N R 12 E
1/4 miles West of Wiggins
(distance) (direction) (nearest town)

WELL PURPOSE: Machine shop
(home, irrigation, municipal, industrial)

- WELL COMPLETION DATA:
- (1) diameter (inches) 2
 - (2) total depth (feet) 128
 - (3) static water level (feet) 56 below top of ground.
 - (4) casing Galvanized, 123, (material) (depth)
 - (size) If telescope see back.
 - (5) screen 5, 123 (length) (depth to top)
 - 1 1/4 Solid SS #006 (size) (material)
 - (6) pump 1, 12 (HP) (yield gpm)
 - 2300 1φ (type power)
 - (7) electric log No (yes or no)
 - (organization running log) BWU
 - (8) how well bottom plugged


RECEIVED
OCT 28 1977

MISS. BD. OF WATER COMMISSIONERS

DRILLERS REMARKS: Set 12H
Set @ 84' - 8' of seal
tank Sta. Rite Pump

If well telescopes please sketch and show depths.

GROUND LEVEL

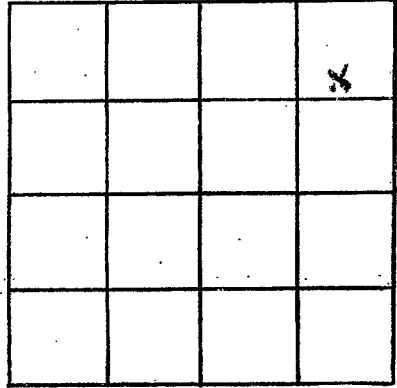

SECTION 26

Please indicate well location X.

ADDITIONAL INFORMATION

If more than one screen, show locations of each on sketch.