

Stone
 B 2010
 10/13/77

MISSISSIPPI
 BOARD OF WATER COMMISSIONERS
 416 North State Street
 Jackson, Mississippi 39201

WATER WELL DRILLERS LOG

10-13 1977 Parrell Anderson Stone
 date well completed firm name county well located

LANDOWNER:
Larry Taylor Ford
Ine.
 (mailing address)

description of formations encountered	from	to
<u>Top Soil</u>	<u>0</u>	<u>3</u>
<u>Red Sand</u>	<u>3</u>	<u>35</u>
<u>Coarse Sand</u>	<u>35</u>	<u>102</u>

WELL LOCATION:
 sec 25 T 2 R 12
1/4 miles W of Weyburn
 (distance) (direction) (nearest town)

WELL PURPOSE: MUNIC.
 (home, irrigation, municipal, industrial)

WELL COMPLETION DATA:

(1) diameter (inches) 2"

(2) total depth (feet) 102'

(3) static water level (feet) 57' below above top of ground.

(4) casing Plastic 97'
 (material) (depth)

(size) If telescope see back.

(5) screen 5" 97'
 (length) (depth to top)

2" Plastic
 (size) (material)

(6) pump 1 11
 (HP) (yield gpm)

Elect
 (type power)

(7) electric log No
 (yes or no)

(organization running log)

(8) how well bottom plugged Capped


DRILLERS REMARKS:

RECEIVED
 NOV - 8 1977

MISS. BD. OF WATER COMM

If well telescopes please sketch and show depths.

GROUND LEVEL

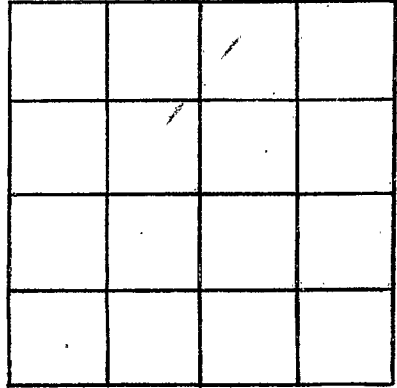

SECTION _____

Please indicate well location X.

ADDITIONAL INFORMATION

If more than one screen, show locations of each on sketch.